


1 LOCATION OF WATER WELL:	Fraction	Section Number	Township Number	Range Number
County: <u>Thomas</u>	<u>NW 1/4 SW 1/4 NE 1/4</u>	<u>22</u>	T <u>10</u> S	R <u>31</u> <u>W</u>

Distance and direction from nearest town or city street address of well if located within city?

75 3 W of Menlo

2 WATER WELL OWNER:	Board of Agriculture, Division of Water Resources
RR#, St. Address, Box # :	Application Number:
City, State, ZIP Code :	

3 LOCATE WELL'S LOCATION WITH AN "X" IN SECTION BOX:	4 DEPTH OF COMPLETED WELL: <u>80</u> ft. ELEVATION:
--	---

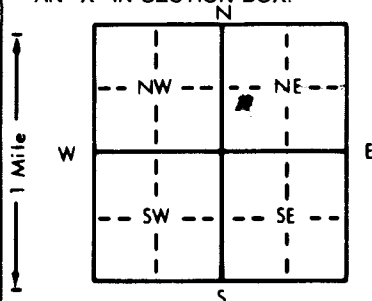

Depth(s) Groundwater Encountered 1. <u>52</u> ft. 2. . ft. 3. . ft.
WELL'S STATIC WATER LEVEL <u>52</u> ft. below land surface measured on mo/day/yr
Pump test data: Well water was ft. after hours pumping gpm
Est. Yield gpm: Well water was ft. after hours pumping gpm
Bore Hole Diameter 9 in. to 80 ft., and in. to ft.
WELL WATER TO BE USED AS:
<input checked="" type="radio"/> Domestic 3 Feedlot 6 Oil field water supply 9 Dewatering 11 Injection well <input type="radio"/> Irrigation 4 Industrial 7 Lawn and garden only 10 Monitoring well 12 Other (Specify below)
Was a chemical/bacteriological sample submitted to Department? Yes No <input checked="" type="checkbox"/> If yes, mo/day/yr sample was submitted
Water Well Disinfected? Yes <input checked="" type="checkbox"/> No

5 TYPE OF BLANK CASING USED:	5 Wrought iron	8 Concrete tile	CASING JOINTS: Glued <input checked="" type="checkbox"/> Clamped
------------------------------	----------------	-----------------	--

1 Steel	3 RMP (SR)	6 Asbestos-Cement	9 Other (specify below)	Welded
<input checked="" type="radio"/> PVC	4 ABS	7 Fiberglass		Threaded

Blank casing diameter 5 in. to 80 ft., Dia in. to ft., Dia in. to ft.

Casing height above land surface 12 in., weight 250 lbs./ft. Wall thickness or gauge No. <u>1250</u>
--

TYPE OF SCREEN OR PERFORATION MATERIAL:	<input checked="" type="radio"/> PVC	10 Asbestos-cement
---	--------------------------------------	--------------------

1 Steel	3 Stainless steel	5 Fiberglass	8 RMP (SR)	11 Other (specify)
2 Brass	4 Galvanized steel	6 Concrete tile	9 ABS	12 None used (open hole)

SCREEN OR PERFORATION OPENINGS ARE:	5 Gauzed wrapped	8 Saw cut	11 None (open hole)
-------------------------------------	------------------	-----------	---------------------

<input checked="" type="radio"/> Continuous slot	3 Mill slot	6 Wire wrapped	9 Drilled holes
2 Louvered shutter	4 Key punched	7 Torch cut	10 Other (specify)

SCREEN-PERFORATED INTERVALS:	From 70 ft. to 80 ft., From ft. to ft.
------------------------------	--

GRAVEL PACK INTERVALS:	From 52 ft. to 80 ft., From ft. to ft.
------------------------	--

From 52 ft. to 80 ft., From ft. to ft.
--

6 GROUT MATERIAL:	<input checked="" type="radio"/> Neat cement	2 Cement grout	3 Bentonite	4 Other
-------------------	--	----------------	-------------	-------------------

Grout Intervals: From 0 ft. to 20 ft., From ft. to ft., From ft. to ft.

What is the nearest source of possible contamination:	10 Livestock pens	14 Abandoned water well
---	-------------------	-------------------------

1 Septic tank	4 Lateral lines	7 Pit privy	11 Fuel storage	15 Oil well/Gas well
2 Sewer lines	5 Cess pool	8 Sewage lagoon	12 Fertilizer storage	16 Other (specify below)
3 Watertight sewer lines	6 Seepage pit	9 Feedyard	13 Insecticide storage	<u>Draw</u>

Direction from well? <u>South</u>	How many feet? <u>500</u>
-----------------------------------	---------------------------

FROM	TO	LITHOLOGIC LOG	FROM	TO	PLUGGING INTERVALS
------	----	----------------	------	----	--------------------

0	22	Topsoil			
---	----	---------	--	--	--

22	34	Sandy Clay			
----	----	------------	--	--	--

34	55	M. Gravel			
----	----	-----------	--	--	--

55	75	Sandy Clay			
----	----	------------	--	--	--

75	80	Chert			
----	----	-------	--	--	--

--	--	--	--	--	--

--	--	--	--	--	--

INSTRUCTIONS: Use typewriter or ball point pen. PLEASE PRESS FIRMLY and PRINT clearly. Please fill in blanks, underline or circle the correct answers. Send top three copies to Kansas Department of Health and Environment, Bureau of Water Protection, Topeka, Kansas 66620-7320. Telephone: 913-296-5514. Send one to WATER WELL OWNER and retain one for your records.

7 CONTRACTOR'S OR LANDOWNER'S CERTIFICATION: This water well was <input checked="" type="radio"/> constructed, <input type="radio"/> reconstructed, or <input type="radio"/> plugged under my jurisdiction and was completed on (mo/day/year) <u>7-28-82</u> and this record is true to the best of my knowledge and belief. Kansas Water Well Contractor's License No. <u>376</u> This Water Well Record was completed on (mo/day/yr) <u>12-82</u> under the business name of <u>B & B Drilling</u> by (signature) <u>Joseph Beckman</u>
