


1 LOCATION OF WATER WELL:		Fraction			Section Number		Township Number		Range Number					
County:	Thomas	SW	1/4	SW	1/4	NE	1/4	25	T	10	S	R	31	E/W

Distance and direction from nearest town or city street address of well if located within city?

5 1/2 miles East. 2 miles North, 1/2 miles East of Oakley, Kansas

2	WATER WELL OWNER: <b>William Bixeman</b>	<b>Murfin Drilling Company</b>	
	RR#, St. Address, Box # : <b>Route 1</b>	<b>P.O. Box 661</b>	Board of Agriculture, Division of Water Resources
	City, State, ZIP Code : <b>Grinnell, KS 67738</b>	<b>Colby, Kansas 67701</b>	Application Number:

3 LOCATE WELL'S LOCATION WITH AN "X" IN SECTION BOX: 4 DEPTH OF COMPLETED WELL: 165 ft. ELEVATION:

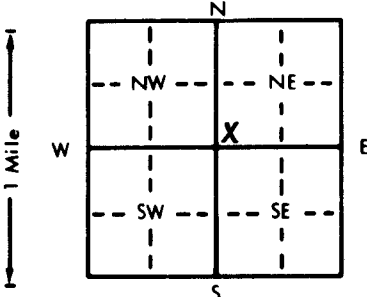

4 DEPTH OF COMPLETED WELL.....165..... ft. ELEVATION: .....  
 Depth(s) Groundwater Encountered 1..... ft. 2..... ft. 3..... ft.  
 WELL'S STATIC WATER LEVEL ....87..... ft. below land surface measured on mo/day/yr April 15, 1985  
     Pump test data: Well water was ..... ft. after ..... hours pumping ..... gpm  
 Est. Yield ..... gpm Well water was ..... ft. after ..... hours pumping ..... gpm  
 Bore Hole Diameter..... in. to ..... ft., and..... in. to ..... ft.  
 WELL WATER TO BE USED AS:  
     1 Domestic      3 Feedlot      6 Oil field water supply      9 Dewatering      11 Injection well  
     2 Irrigation     4 Industrial    7 Lawn and garden only    10 Observation well  
 Was a chemical/bacteriological sample submitted to Department? Yes.....No.....; If yes, mo/day/yr sample was sub-  
 mitted Water Well Disinfected? Yes No

5 TYPE OF BLANK CASING USED:		5 Wrought iron	8 Concrete tile	CASING JOINTS: Glued . . . . . Clamped . . . . .	
1 Steel	3 RMP (SR)	6 Asbestos-Cement	9 Other (specify below)	Welded . . . . .	
2 PVC	4 ABS	7 Fiberglass		Threaded. . . . .	
Blank casing diameter <u>5</u> in. to <u>145</u> ft. Dia				in. to . . . . . ft. Dia	

Casing height above land surface. 3' below . . . . . in., weight . . . . . lbs./ft. Wall thickness or gauge No. . . . .

TYPE OF SCREEN OR PERFORATION MATERIAL:			7 PVC	10 Asbestos-cement
1 Steel	3 Stainless steel	5 Fiberglass	8 RMP (SR)	11 Other (specify) .....
2 Brass	4 Galvanized steel	6 Concrete tile	9 ABS	12 None used (open hole)

SCREEN OR PERFORATION OPENINGS ARE:		5 Gauzed wrapped	<u>8 Saw cut</u>	11 None (open hole)
1 Continuous slot	3 Mill slot	6 Wire wrapped	9 Drilled holes	
2 Louvered shutter	4 Key punched	7 Torch cut	10 Other (specify) .....	

SCREEN-PERFORATED INTERVALS:	From	145	ft. to	165	ft., From	ft. to	ft.
	From		ft. to		ft., From	ft. to	ft.
GRAVEL PACK INTERVALS:	From		ft. to		ft., From	ft. to	ft.
	From		ft. to		ft., From	ft. to	ft.

5. GROUT MATERIAL: 1 Neat cement 2 Cement grout 3 Bentonite 4 Other .....

Grout Intervals: From ..... ft. to ..... ft., From ..... ft. to ..... ft., From ..... ft. to ..... ft.

What is the nearest source of possible contamination:

1 Septic tank	4 Lateral lines	7 Pit privy	10 Livestock pens	14 Abandoned water well
2 Sewer lines	5 Cess pool	8 Sewage lagoon	11 Fuel storage	15 Oil well/Gas well
3 Watertight sewer lines	6 Seepage pit	9 Feedyard	12 Fertilizer storage	16 Other (specify below)
			13 Insecticide storage	.....

[illegible][illegible]

7. CONTRACTOR'S OR LANDOWNER'S CERTIFICATION: This water well was (1) constructed, (2) reconstructed, or (3) plugged under my jurisdiction and was completed on (mo/day/year) April 15, 1985 and this record is true to the best of my knowledge and belief. Kansas

Water Well Contractor's License No. 394 This Water Well Record was completed on (mo/day/yr) April 30, 1985  
under the business name of Wooster Pump & Well by (signature) W. O. Wooster

INSTRUCTIONS: Use typewriter or ball point pen, **PLEASE PRESS FIRMLY** and **PRINT** clearly. Please fill in blanks, underline or circle the correct answers. Send top three copies to Kansas Department of Health and Environment, Division of Environment, Environmental Geology Section, Topeka, KS 66620. Send one to **WATER WELL OWNER** and retain one for your records.