

WATER WELL PLUGGING RECORD

Form WWC-5P

KSA 82a-1212

ID No.

IW-5


Corrected

| | | | | |
|--|---|-----------------------------|------------------------------|---------------------------|
| 1 LOCATION OF WATER WELL: County: <u>Thomas</u> | Fraction <u>SW 1/4 SW 1/4 NW 1/4</u> | Section Number <u>14</u> | Township Number <u>10</u> | Range Number <u>32</u> |
|--|---|-----------------------------|------------------------------|---------------------------|

Distance and direction from nearest town or city street address of well if located within city?
JJ Oil Company (Oakley)

2 WATER WELL OWNER: JJ Oil Company #6
 RR#, St. Address, Box # _____
 City, State, ZIP Code : Oakley, KS 67748
 Board of Agriculture, Division of Water Resources
 Application Number: _____

3 MARK WELL'S LOCATION WITH AN "X" IN SECTION BOX:

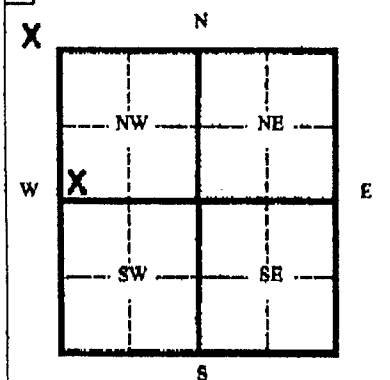

4 DEPTH OF WELL 90 ft.

WELL'S STATIC WATER LEVEL _____ ft.

WELL WAS USED AS:

| | | |
|--------------|------------------------------|--------------------------|
| 1 Domestic | 5 Public Water Supply | 9 Dewatering |
| 2 Irrigation | 6 Oil Field Water Supply | 10 Monitoring Well |
| 3 Feedlot | 7 Lawn and Garden (domestic) | <u>11</u> Injection Well |
| 4 Industrial | 8 Air Conditioning | 12 Other _____ |

Was a chemical/bacteriological sample submitted to Department? Yes _____ No X
 If yes, mo/day/yr sample was submitted _____
 Water Well Disinfected: Yes _____ No _____

5 TYPE OF BLANK CASING USED:

| | | | | |
|--------------|------------|-------------------|-----------------|-------------------------|
| 1 Steel | 3 RMP (SR) | 5 Wrought | 7 Fiberglass | 9 Other (specify below) |
| <u>2</u> PVC | 4 ABC | 6 Asbestos-Cement | 8 Concrete Tile | |

Blank casing diameter 2 in. Was casing pulled? Yes X No _____ If yes, how much Removed 3 ft
 Casing height above or below land surface -36 in.

6 GROUT PLUG MATERIAL: 1 Neat cement 2 Cement grout 3 Bentonite 4 Other _____

Grout Plug Intervals From 0 ft. to 90 ft. From _____ ft. to _____ ft. From _____ ft. to _____ ft.

What is the nearest source of possible contamination:

| | | | |
|--------------------------|-------------------|-------------------------|--------------------------|
| 1 Septic tank | 6 Seepage pit | 11 Fuel storage | 16 Other (specify below) |
| 2 Sewer lines | 7 Pit privy | 12 Fertilizer storage | |
| 3 Watertight sewer lines | 8 Sewage lagoon | 13 Insecticide storage | |
| 4 Lateral lines | 9 Feedyard | 14 Abandoned water well | |
| 5 Cess Pool | 10 Livestock pens | 15 Oil well/ Gas well | |

Direction from well? _____ How many feet? _____

| FROM | TO | CODE | PLUGGING MATERIALS |
|------|----|------|--------------------|
| 0 | 90 | | Bentonite |
| | | | |
| | | | |
| | | | |
| | | | |
| | | | |

RECEIVED
 JAN 08 2009
 BUREAU OF WATER

7 CONTRACTOR'S OR LANDOWNER'S CERTIFICATION: This water well was plugged under my jurisdiction and was completed on (mo/day/yr) 6/26/07 and this record is true to the best of my knowledge and belief. Kansas Water Well Contractor's License No. 554 This Water Well Record was completed on (mo/day/yr) 7/2/07 under the business name of Woofer Pump and Well by (signature) Joy Woofers

INSTRUCTIONS: Please fill in blanks and circle the correct answers. Send three copies to Kansas Department of Health and Environment, Bureau of Water, 1000 S W Jackson St., Ste. 420, Topeka, Kansas 66620-0001. Telephone: 785-298-3585. Send one to Water Well Owner and retain one for your records.