


1 LOCATION OF WATER WELL:	Fraction	Section Number	Township Number	Range Number
County: THOMAS	SW 1/4 SW 1/4 SW 1/4	6	T 10 S S	R 32 W EW

Distance and direction from nearest town or city street address of well if located within city?

6 m 4 w 70 mly

2 WATER WELL OWNER:	BLUE GOOSE DRILLING	Board of Agriculture, Division of Water Resources
RR#, St. Address, Box # :	BOX 1413	Application Number: T 87-490
City, State, ZIP Code :	GREAT BEND, KANSAS 67530	

3 LOCATE WELL'S LOCATION WITH AN "X" IN SECTION BOX:	4 DEPTH OF COMPLETED WELL: 222 ft. ELEVATION:
--	---

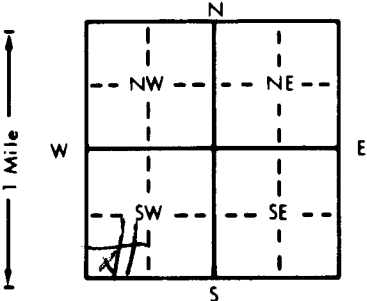

Depth(s) Groundwater Encountered 1. 120 ft. 2. ft. 3. ft.

WELL'S STATIC WATER LEVEL 220 120 ft. below land surface measured on mo/day/yr

Pump test data: Well water was ft. after hours pumping gpm

Est. Yield 50 gpm: Well water was ft. after hours pumping gpm

Bore Hole Diameter 9 in. to 222 ft., and in. to ft.

WELL WATER TO BE USED AS:

- | | | | | |
|--------------|--------------|--------------------------|---------------------|--------------------------|
| 1 Domestic | 3 Feedlot | 6 Oil field water supply | 9 Dewatering | 12 Other (Specify below) |
| 2 Irrigation | 4 Industrial | 7 Lawn and garden only | 10 Observation well | |

Was a chemical/bacteriological sample submitted to Department? Yes.....No...X.....; If yes, mo/day/yr sample was submitted

Water Well Disinfected? Yes X No

5 TYPE OF BLANK CASING USED:	5 Wrought iron	8 Concrete tile	CASING JOINTS: Glued X Clamped	
1 Steel	3 RMP (SR)	6 Asbestos-Cement	9 Other (specify below)	Welded
2 PVC	4 ABS	7 Fiberglass		Threaded

Blank casing diameter 5 in. to 212 ft., Dia. in. to ft., Dia. in. to ft.

Casing height above land surface 12 in., weight 250 lbs./ft. Wall thickness or gauge No. 250

TYPE OF SCREEN OR PERFORATION MATERIAL:	7 PVC	10 Asbestos-cement		
1 Steel	3 Stainless steel	5 Fiberglass	8 RMP (SR)	11 Other (specify)
2 Brass	4 Galvanized steel	6 Concrete tile	9 ABS	12 None used (open hole)

SCREEN OR PERFORATION OPENINGS ARE:

- | | | | | |
|--------------------|---------------|------------------|--------------------|---------------------|
| 1 Continuous slot | 3 Mill slot | 5 Gauzed wrapped | 8 Saw cut | 11 None (open hole) |
| 2 Louvered shutter | 4 Key punched | 6 Wire wrapped | 9 Drilled holes | |
| | | 7 Torch cut | 10 Other (specify) | |

SCREEN-PERFORATED INTERVALS: From 212 ft. to 222 ft., From ft. to ft.

From ft. to ft., From ft. to ft.

GRAVEL PACK INTERVALS: From 120 ft. to 222 ft., From ft. to ft.

From ft. to ft., From ft. to ft.

6 GROUT MATERIAL:	1 Neat cement	2 Cement grout	3 Bentonite	4 Other
-------------------	---------------	----------------	-------------	---------

Grout intervals: From 0 ft. to 20 ft., From ft. to ft., From ft. to ft.

What is the nearest source of possible contamination:

- | | | | | |
|--------------------------|-----------------|-----------------|------------------------|--------------------------|
| 1 Septic tank | 4 Lateral lines | 7 Pit privy | 10 Livestock pens | 14 Abandoned water well |
| 2 Sewer lines | 5 Cess pool | 8 Sewage lagoon | 11 Fuel storage | 15 Oil well/Gas well |
| 3 Watertight sewer lines | 6 Seepage pit | 9 Feedyard | 12 Fertilizer storage | 16 Other (specify below) |
| | | | 13 Insecticide storage | |

Direction from well? West How many feet? 660

FROM	TO	LITHOLOGIC LOG	FROM	TO	LITHOLOGIC LOG
0	31	Topsoil			
31	49	M. Gravel			
49	66	Sandy Clay			
66	78	M. Gravel			
78	90	Gravel			
90	112	Sandy Clay			
112	131	M. Gravel			
131	165	Sandy Clay			
165	177	Fine Sand			
177	187	Sandy Clay - Fine Sand			
187	194	Sandy Clay			
194	206	Sandy Clay			
206	220	M. Gravel			
220	222	Centre			

7 CONTRACTOR'S OR LANDOWNER'S CERTIFICATION: This water well was (1) constructed, (2) reconstructed, or (3) plugged under my jurisdiction and was completed on (mo/day/year) 4-88 and this record is true to the best of my knowledge and belief. Kansas
--

Water Well Contractor's License No. 376 This Water Well Record was completed on (mo/day/yr) 5-88

under the business name of B & B DRILLING by (signature) Joseph Beckman

INSTRUCTIONS: Use typewriter or ball point pen. PLEASE PRESS FIRMLY and PRINT clearly. Please fill in blanks, underline or circle the correct answers. Send top three copies to Kansas Department of Health and Environment, Bureau of Water Protection, Topeka, Kansas 66620-7320, Telephone: 913-862-9360. Send one to WATER WELL OWNER and retain one for your records.