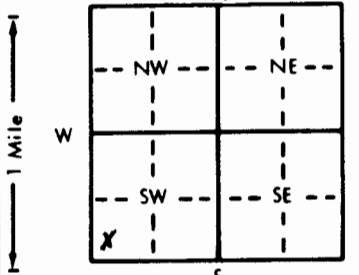


1 LOCATION OF WATER WELL:		Fraction	Section Number	Township Number	Range Number
County: <u>Thomas</u>		<u>SW 1/4 SW 1/4 SW 1/4</u>	<u>13</u>	T <u>10</u> S	R <u>32</u> EW
Distance and direction from nearest town or city street address of well if located within city?					
<u>+ N 1 E of Oakley</u>					
2 WATER WELL OWNER: <u>Mr. Jim Mitton</u>					
RR#, St. Address, Box # : <u>Oakley, KS 67748</u>					
City, State, ZIP Code : <u>Oakley, KS 67748</u>					
Board of Agriculture, Division of Water Resources					
Application Number:					
3 LOCATE WELL'S LOCATION WITH AN "X" IN SECTION BOX:		4 DEPTH OF COMPLETED WELL: <u>91</u> ft. ELEVATION:			
		WELL'S STATIC WATER LEVEL <u>48</u> ft. below land surface measured on mo/day/yr			
		WELL WATER TO BE USED AS: 5 Public water supply 8 Air conditioning 11 Injection well			
		<u>1</u> Domestic 3 Feedlot 6 Oil field water supply 9 Dewatering 12 Other (Specify below)			
		2 Irrigation 4 Industrial 7 Lawn and garden only 10 Monitoring well			
		Was a chemical/bacteriological sample submitted to Department? Yes <u>X</u> No <u>X</u> ; If yes, mo/day/yr sample was submitted			
		Water Well Disinfected? Yes <u>X</u> No <u>X</u>			
5 TYPE OF BLANK CASING USED:					
1 Steel 3 RMP (SR) 5 Wrought iron 8 Concrete tile CASING JOINTS: Glued <u>X</u> Clamped <u>X</u>					
2 PVC 4 ABS 6 Asbestos-Cement 9 Other (specify below) Welded <u>X</u>					
TYPE OF SCREEN OR PERFORATION MATERIAL:					
1 Steel 3 Stainless steel 5 Fiberglass 8 RMP (SR) 10 Asbestos-cement					
2 Brass 4 Galvanized steel 6 Concrete tile 9 ABS 11 Other (specify)					
12 None used (open hole)					
SCREEN OR PERFORATION OPENINGS ARE:					
1 Continuous slot 3 Mill slot 5 Gauzed wrapped 8 Saw cut 11 None (open hole)					
2 Louvered shutter 4 Key punched 6 Wire wrapped 9 Drilled holes					
7 Torch cut 10 Other (specify)					
What is the nearest source of possible contamination:					
1 Septic tank 4 Lateral lines 7 Pit privy 10 Livestock pens 14 Abandoned water well					
2 Sewer lines 5 Cess pool 8 Sewage lagoon 11 Fuel storage 15 Oil well/Gas well					
3 Watertight sewer lines 6 Seepage pit 9 Feedyard 12 Fertilizer storage 16 Other (specify below)					
13 Insecticide storage					
Direction from well? <u>East</u> How many feet? <u>50</u>					
FROM		TO		LITHOLOGIC LOG	
FROM		TO		PLUGGING INTERVALS	
0		16		Topsoil	
16		45		Sandy Clay	
45		60		M. H. Havel	
60		65		Sandy Clay	
65		84		M. H. Havel	
84		90		Arguel	
90		91		Ochre	
7 CONTRACTOR'S OR LANDOWNER'S CERTIFICATION: This water well was <u>1</u> constructed, (2) reconstructed, or (3) plugged under my jurisdiction and was completed on (mo/day/year) <u>9-91</u> and this record is true to the best of my knowledge and belief. Kansas Water Well Contractor's License No. <u>376</u> This Water Well Record was completed on (mo/day/yr) <u>11-91</u> under the business name of <u>B & B Drilling</u> by (signature) <u>Joseph B. Buchanan</u>					