


1 LOCATION OF WATER WELL: County: Thomas	Fraction SE 1/4 NE 1/4 NE 1/4	Section Number 36	Township Number T 10 S	Range Number R 32 E/W
--	---	-----------------------------	----------------------------------	---------------------------------

Distance and direction from nearest town or city street address of well if located within city?

1/2 mile East, 1/2 mile North of Oakley, Kansas

2 WATER WELL OWNER: Alva George RR#, St. Address, Box # : Route 1 City, State, ZIP Code : Oakley, Kansas 67748	Murfin Drilling Company P.O. Box 661 Colby, Kansas 67701 Board of Agriculture, Division of Water Resources Application Number:
---	---

3 LOCATE WELL'S LOCATION WITH AN "X" IN SECTION BOX:	4 DEPTH OF COMPLETED WELL: 180 ft. ELEVATION:
--	--

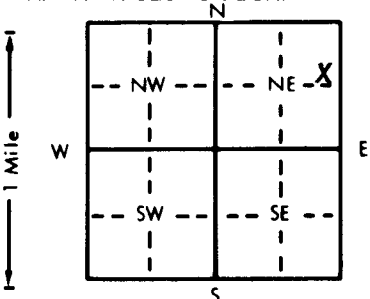

Depth(s) Groundwater Encountered 1. ft. 2. ft. 3. ft.

WELL'S STATIC WATER LEVEL **86** ft. below land surface measured on mo/day/yr **June 11, 1985**

Pump test data: Well water was ft. after hours pumping gpm

Est. Yield gpm: Well water was ft. after hours pumping gpm

Bore Hole Diameter **9** in. to **180** ft. and in. to ft.

WELL WATER TO BE USED AS: 5 Public water supply 8 Air conditioning 11 Injection well

1 Domestic 3 Feedlot 6 Oil field water supply 9 Dewatering 12 Other (Specify below)

2 Irrigation 4 Industrial 7 Lawn and garden only 10 Observation well

Was a chemical/bacteriological sample submitted to Department? Yes No **X** If yes, mo/day/yr sample was submitted
Water Well Disinfected? Yes **X** No

5 TYPE OF BLANK CASING USED:	5 Wrought iron	8 Concrete tile	CASING JOINTS: Glued X Clamped
1 Steel	3 RMP (SR)	6 Asbestos-Cement	9 Other (specify below)
2 PVC	4 ABS	7 Fiberglass	Threaded.

Blank casing diameter in. to **160** ft. Dia in. to ft. Dia in. to ft.Casing height above land surface. in., weight **2.81** lbs./ft. Wall thickness or gauge No. **265**

TYPE OF SCREEN OR PERFORATION MATERIAL:	7 PVC	10 Asbestos-cement
1 Steel	3 Stainless steel	5 Fiberglass
2 Brass	4 Galvanized steel	8 RMP (SR)
	6 Concrete tile	9 ABS
		11 Other (specify)
		12 None used (open hole)

SCREEN OR PERFORATION OPENINGS ARE:	5 Gauzed wrapped	8 Saw cut	11 None (open hole)
1 Continuous slot	3 Mill slot	6 Wire wrapped	9 Drilled holes
2 Louvered shutter	4 Key punched	7 Torch cut	10 Other (specify)

SCREEN-PERFORATED INTERVALS: From **160** ft. to **180** ft. From ft. to ft.

From ft. to ft. From ft. to ft.

GRAVEL PACK INTERVALS: From **10** ft. to **180** ft. From ft. to ft.

From ft. to ft. From ft. to ft.

6 GROUT MATERIAL:	1 Neat cement	2 Cement grout	3 Bentonite	4 Other
Grout Intervals: From 0 ft. to 10 ft.	From ft. to ft.	From ft. to ft.	From ft. to ft.	From ft. to ft.

What is the nearest source of possible contamination:

1 Septic tank	4 Lateral lines	7 Pit privy	10 Livestock pens	14 Abandoned water well
2 Sewer lines	5 Cess pool	8 Sewage lagoon	11 Fuel storage	15 Oil well/Gas well
3 Watertight sewer lines	6 Seepage pit	9 Feedyard	12 Fertilizer storage	16 Other (specify below)
			13 Insecticide storage	

Direction from well? **north** How many feet? **1000**

FROM	TO	LITHOLOGIC LOG	FROM	TO	LITHOLOGIC LOG
0	3	surface			
3	39	clay			
39	42	caliche			
42	67	clay			
67	72	med. sand			
72	87	clay			
87	96	med. sand			
96	159	clay & caliche layers			
159	177	med. sand			
177	181	ochre			
181	185	shale			

7 CONTRACTOR'S OR LANDOWNER'S CERTIFICATION: This water well was (1) constructed, (2) reconstructed, or (3) plugged under my jurisdiction and was completed on (mo/day/year) June 11, 1985 and this record is true to the best of my knowledge and belief. Kansas
--

Water Well Contractor's License No. **394** This Water Well Record was completed on (mo/day/yr) **June 24, 1985**under the business name of **Woofter Pump & Well** by (signature) **Walt Woot**INSTRUCTIONS: Use typewriter or ball point pen, **PLEASE PRESS FIRMLY** and **PRINT** clearly. Please fill in blanks, underline or circle the correct answers. Send top three copies to Kansas Department of Health and Environment, Division of Environment, Environmental Geology Section, Topeka, KS 66620. Send one to WATER WELL OWNER and retain one for your records.