


1 LOCATION OF WATER WELL: Fraction NE 1/4 NE 1/4 SW 1/4 Section Number 25 Township Number T 10 S Range Number R 37 E  
 County: Sherman

Distance and direction from nearest town or city street address of well if located within city?  
1/4 mile east & 14/4 mile north of Brewster

2 WATER WELL OWNER: Don Cronston  
 RR#, St. Address, Box # : 327 Co Rd. F Board of Agriculture, Division of Water Resources  
 City, State, ZIP Code : Brewster, KS 67732 Application Number:

3 LOCATE WELL'S LOCATION WITH AN "X" IN SECTION BOX: 4 DEPTH OF COMPLETED WELL 230 ft. ELEVATION:

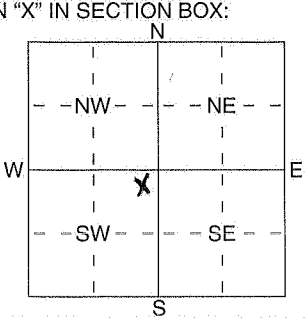

Depth(s) Groundwater Encountered ..... ft. 2 ..... ft. 3 ..... ft.  
 WELL'S STATIC WATER LEVEL 174 ft. below land surface measured on mo/day/yr 5-15-13  
 Pump test data: Well water was ..... ft. after ..... hours pumping ..... gpm  
 Est. Yield ..... gpm: Well water was ..... ft. after ..... hours pumping ..... gpm  
 WELL WATER TO BE USED AS: 5 Public water supply 8 Air conditioning 11 Injection well  
 Domestic 3 Feedlot 6 Oil field water supply 9 Dewatering 12 Other (Specify below)  
 2 Irrigation 4 Industrial 7 Domestic (lawn & garden) 10 Monitoring well .....  
 Was a chemical/bacteriological sample submitted to Department? Yes ..... No X .....; If yes, mo/day/yr sample was submitted  
 Water Well Disinfected? Yes X No

5 TYPE OF BLANK CASING USED: 5 Wrought iron 8 Concrete tile CASING JOINTS: Glued X Clamped .....  
 1 Steel 3 RMP (SR) 6 Asbestos-Cement 9 Other (specify below) Welded .....  
 PVC X 4 ABS 7 Fiberglass ..... Threaded .....

Blank casing diameter ..... 5 in. to ..... ft., Dia ..... in. to ..... ft., Dia ..... in. to ..... ft.  
 Casing height above land surface ..... 24 in., weight ..... 2.5 lbs./ft. Wall thickness or gauge No. 1/4"

TYPE OF SCREEN OR PERFORATION MATERIAL:  PVC X 10 Asbestos-Cement  
 1 Steel 3 Stainless Steel 5 Fiberglass 8 RMP (SR) 11 Other (Specify) .....  
 2 Brass 4 Galvanized Steel 6 Concrete tile 9 ABS 12 None used (open hole)

SCREEN OR PERFORATION OPENINGS ARE: 5 Gauzed wrapped  Saw cut X 11 None (open hole)  
 1 Continuous slot 3 Mill slot 6 Wire wrapped 9 Drilled holes  
 2 Louvered shutter 4 Key punched 7 Torch cut 10 Other (specify) ..... ft.

SCREEN-PERFORATED INTERVALS: From 230 ft. to 210 ft., From ..... ft. to ..... ft.  
 GRAVEL PACK INTERVALS: From 230 ft. to 20 ft., From ..... ft. to ..... ft.

6 GROUT MATERIAL:  Neat cement X 2 Cement grout 3 Bentonite 4 Other .....  
 Grout Intervals: From 3' ft. to 20 ft., From ..... ft. to ..... ft., From ..... ft. to ..... ft.

What is the nearest source of possible contamination: 10 Livestock pens 14 Abandoned water well  
 1 Septic tank 4 Lateral lines 7 Pit privy 11 Fuel storage 15 Oil well/Gas well  
 2 Sewer lines 5 Cess pool 8 Sewage lagoon 12 Fertilizer storage 16 Other (specify below)  
 3 Watertight sewer lines 6 Seepage pit 9 Feedyard 13 Insecticide storage irrigation well  
 Direction from well? North How many feet? 200 ft. north

FROM	TO	LITHOLOGIC LOG	FROM	TO	PLUGGING INTERVALS
0	15	top soil			
15	35	sand & clay dark			
35	50	sand & clay			
50	80	stone			
80	120	hard tight sand			
120	138	tight clay			
138	148	loose sand & clay stripes			
148	160	loose sand			
160	200	Loose sand & clay stripes			
200	215	Loose sand			
215	228	sand			
228	230	shale			

7 CONTRACTOR'S OR LANDOWNER'S CERTIFICATION: This water well was  constructed, (2) reconstructed, or (3) plugged under my jurisdiction and was completed on (mo/day/year) 5-15-2013 and this record is true to the best of my knowledge and belief. Kansas Water Well Contractor's Licence No 649. This Water Well Record was completed on (mo/day/yr) 6-18-2013 under the business name of Bartell Drilling by (signature) Wayne Bartell