

McALPASTER NW

T R EW sec 1/4 1/4 1/4 No.

USE TYPEWRITER OR BALL POINT PEN—PRESS FIRMLY, PRINT CLEARLY.

AAA WATER WELL RECORD KSA 82a-1201-1215 NE NE 1/4 NE 1/4

Kansas State Dept. Of Health (Water Well Contractors) Forbes-Bldg. 740 Topeka, Kansas 66620


1 Location of well:	County <u>Shoeman</u> <u>Flour</u>	Township name	Fraction <u>NE 1/4</u>	Section number <u>24</u>	Town number <u>10S</u>	Range number <u>37W</u>
---------------------	---------------------------------------	---------------	------------------------	--------------------------	------------------------	-------------------------

Distance and direction from nearest town or city: _____

Street address of well location if in city: _____

3 Owner of well: Jerome Berry

Address: Colby, Ks.

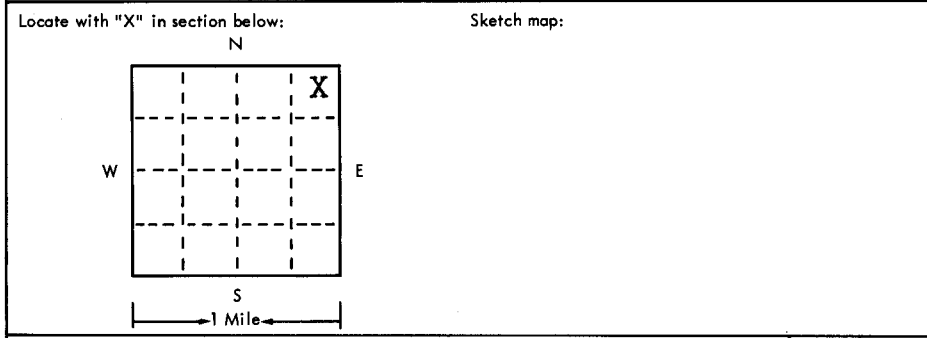

4 Well depth: 226 ft. Date of completion 7-12-75

Well diameter 28 in.

5 Cable tool Rotary Driven Dug
 Hollow rod Jetted Bored Reverse rotary

6 Use: Domestic Public supply Industry
 Irrigation Air conditioning Commercial
 Test well

7 Casing: Material Steel Height: above/below
 Threaded Welded Surface 12 in.
 Dia. 12 3/4 in. Weight 34.9 lbs./ft.
 to 226 ft. depth Drive shoe? Yes No

2	Type and color of material	From	To
	Fine sand, Med Gravel, rock (brown)	120	125
	Fine sand, Sandy clay, sandstone	125	132
	Clay (yellow)	132	140
	Fine sand, Med gravel (brown)	140	146
	Fine sand, Sandy clay, Sandstone (brown)	146	170
	Fine sand, sandstone (brown white)	170	186
	Fine sand, Med Gravel (brown)	186	209
	Fine sand, Sandy clay, Med Gravel brown	209	212
	Fine sand, Med Gravel (brown)	212	222
	Shale (blue)	222	226
	<u>BROCK 222'</u>		
	(use a second sheet if needed)		

8 Screen: Manufacturer Johnson
 Type 510T Dia. 1 3/4
 Slot/gauze 100 Length 10'
 Set between 216 ft. and 226 ft.
 Fittings: 1/8-1/2
 Gravel pack Yes No Size range of material _____

9 Static water level: 149 ft. below land surface Date 7-12-75

10 Pumping level below land surfaces:
915 ft. after 8 hrs. pumping 1050 g.p.m.
 _____ ft. after _____ hrs. pumping _____ g.p.m.
 Estimated maximum yield 1050 g.p.m.

11 Water sample submitted:
 Yes No Date _____

12 Well head completion:
 Pitless adapter 12 Inches above grade

13 Well grouted? Yes No
 Neat cement Bentonite _____
 Depth: From 0 ft. to 10 ft.

14 Nearest source of possible contamination:
 ft. 2960 Direction South Type Sewer
 Well disinfected upon completion? Yes No

15 Pump: Not installed
 Manufacturer's name _____
 Model number _____ HP _____ Volts _____
 Length of drop pipe _____ ft. capacity _____ g.p.m.
 Type:
 Submersible Turbine
 Jet Reciprocating
 Centrifugal Other

16 Remarks: elevation 3397 (TOPO)

Topography:
 Hill
 Slope
 Upland
 Valley

17 Water well contractor's certification:
 This well was drilled under my jurisdiction and this report is true to the best of my knowledge and belief.
Red Tiger Irri. 125A
 Business name License No. _____
 Address Box 524 Colby, Ks. 67701
 Signed [Signature] Date 8-29-75
 Authorized representative

10 37W 24 NE NE NE