

USE TYPEWRITER OR BALL
POINT PEN-PRESS FIRMLY,
PRINT CLEARLY.


McALLASTER NW

WATER WELL RECORD
KSA 82a-1201-1215

DBL

Kansas Department of Health and
Environment-Division of Environment
(Water well Contractors)
Topeka, Kansas 66620

1. Location of well:		County Sherman	Fraction SW 1/4 NW 1/4 SE 1/4	Section number 34	Township number T 10 S	Range number R 37 E																																				
2. Distance and direction from nearest town or city: From Brewster 3 1/2 South; 1 East; 12 South Street address of well location if in city:				3. Owner of well: Clair Knox R.R. or street: City, state, zip code: Brewster, Kansas																																						
4. Locate with "X" in section below: N W E S 1 Mile				Sketch map: 6. Bore hole dia. 30 in. Completion date 7-17-76 Well depth 304 ft.																																						
5. Type and color of material <table border="1"><thead><tr><th></th><th>From</th><th>To</th></tr></thead><tbody><tr><td>Sand, Clay</td><td>0</td><td>80</td></tr><tr><td>Clay, Streaks of Sand Stone</td><td>80</td><td>140</td></tr><tr><td>Sandy Clay</td><td>140</td><td>160</td></tr><tr><td>Clay, Streaks of Sand Stone</td><td>160</td><td>180</td></tr><tr><td>Sandy Clay, Streaks of Sand Stone</td><td>180</td><td>200</td></tr><tr><td>Clay, Streaks of Sand Stone</td><td>200</td><td>220</td></tr><tr><td>Sand, Gravel</td><td>220</td><td>229</td></tr><tr><td>Clay, Streaks of Sand</td><td>229</td><td>242</td></tr><tr><td>Sand, Med. Gravel</td><td>242</td><td>260</td></tr><tr><td>Coarse Sand, Med. Gravel</td><td>260</td><td>280</td></tr><tr><td>Med. Gravel</td><td>280</td><td>304</td></tr>Gravel	242	260	Coarse Sand, Med. Gravel	260	280	Med. Gravel	280	304	7. <input type="checkbox"/> Cable tool <input type="checkbox"/> Rotary <input type="checkbox"/> Driven <input type="checkbox"/> Dug <input type="checkbox"/> Hollow rod <input type="checkbox"/> Jetted <input type="checkbox"/> Bored <input checked="" type="checkbox"/> Reverse rotary		
					From	To																																				
				Sand, Clay	0	80																																				
				Clay, Streaks of Sand Stone	80	140																																				
				Sandy Clay	140	160																																				
				Clay, Streaks of Sand Stone	160	180																																				
				Sandy Clay, Streaks of Sand Stone	180	200																																				
				Clay, Streaks of Sand Stone	200	220																																				
				Sand, Gravel	220	229																																				
				Clay, Streaks of Sand	229	242																																				
				Sand, Med. Gravel	242	260																																				
				Coarse Sand, Med. Gravel	260	280																																				
Med. Gravel	280	304	
8. Use: <input type="checkbox"/> Domestic <input type="checkbox"/> Public supply <input type="checkbox"/> Industry <input checked="" type="checkbox"/> Irrigation <input type="checkbox"/> Air conditioning <input type="checkbox"/> Stock <input type="checkbox"/> Lawn <input type="checkbox"/> Oil field water <input type="checkbox"/> Other	
9. Casing: Material Steel Height: Above or below Threaded <input type="checkbox"/> Welded <input checked="" type="checkbox"/> Surface 12 in. RMP <input type="checkbox"/> PVC <input type="checkbox"/> Weight 188 lbs./ft. Dia. 16 in. to 174 ft. depth Wall Thickness: inches or Dia. <input type="checkbox"/> in. to <input type="checkbox"/> ft. depth gage No. #7	
10. Screen: Manufacturer's name Brown Type Regular Dia. 16" Slot/gauze 10% Length 120' Set between 174' ft. and 294 ft. 10' Cook 294 ft. and 304 ft. Gravel pack? <input checked="" type="checkbox"/> Size range of material 2x5/8 30%	
11. Static water level: <input type="checkbox"/> mo./day/yr. 170 ft. below land surface Date 7-20-76	
12. Pumping level below land surfaces: 253 ft. after 2 hrs. pumping 1412 g.p.m. ft. after hrs. pumping g.p.m. Estimated maximum yield 1412 g.p.m.	
13. Water sample submitted: <input type="checkbox"/> mo./day/yr. <input type="checkbox"/> Yes <input checked="" type="checkbox"/> No Date	
14. Well head completion: <input type="checkbox"/> Pitless adapter 12 inches above grade	
15. Well grouted? <input checked="" type="checkbox"/> With: <input type="checkbox"/> Neat cement <input checked="" type="checkbox"/> Bentonite <input checked="" type="checkbox"/> Clay Depth: From 0 ft. to 10 ft.	
16. Nearest source of possible contamination: ft. 2 M Direction SW Type House Well disinfected upon completion? <input type="checkbox"/> Yes <input checked="" type="checkbox"/> No	
17. Pump: Manufacturer's name Floway Not installed Model number 056109 HP 100 Volts 480 Length of drop pipe 280 ft. capacity g.p.m. Type: <input type="checkbox"/> Submersible <input checked="" type="checkbox"/> Turbine <input type="checkbox"/> Jet <input type="checkbox"/> Reciprocating <input type="checkbox"/> Centrifugal <input type="checkbox"/> Other	
18. Elevation:	19. Remarks: 3410 (7000)		20. Water well contractor's certification: This well was drilled under my jurisdiction and this report is true to the best of my knowledge and belief. Western Well & Pump 245 Business name License No. Address Box 852, Colby, KS 67701 Signed Sally Berry Date 9-5-77 Authorized representative																																							

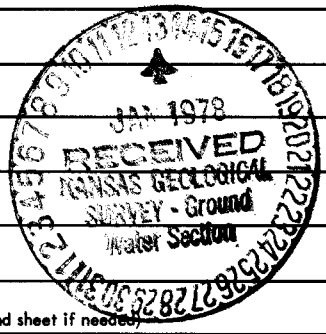

10 37 34 SW NW SE
1/4 1/4 1/4