


1 LOCATION OF WATER WELL: County: Sherman Fraction: SE 1/4 NW 1/4 NW 1/4 Section Number: 19 Township Number: T 10 S Range Number: R 38 E/W

Distance and direction from nearest town or city street address of well if located within city?
11 S & 7 E of goodland Ks. 0274343

2 WATER WELL OWNER: Robert Bradshaw GPS UTM 14S 4339427
 RR#, St. Address, Box #: 202 Spruce Rd Board of Agriculture, Division of Water Resources
 City, State, ZIP Code: Goodland KS 67735 Application Number:

3 LOCATE WELL'S LOCATION WITH AN "X" IN SECTION BOX: 4 DEPTH OF COMPLETED WELL: 136 ft. ELEVATION: 3570

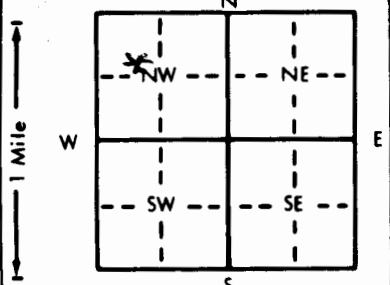

Depth(s) Groundwater Encountered 1. 117 ft. 2. _____ ft. 3. _____ ft.
 WELL'S STATIC WATER LEVEL 117 ft. below land surface measured on mo/day/yr 12-13-05
 Pump test data: Well water was 135 ft. after 1 hours pumping 3 gpm
 Est. Yield 3 gpm: Well water was _____ ft. after _____ hours pumping _____ gpm
 Bore Hole Diameter 10' in. to 20 ft., and 8 in. to 136 ft.
 WELL WATER TO BE USED AS:
 Domestic 3 Feedlot 6 Oil field water supply 9 Dewatering 12 Other (Specify below)
 2 Irrigation 4 Industrial 7 Lawn and garden only 10 Monitoring well
 Was a chemical/bacteriological sample submitted to Department? Yes _____ No If yes, mo/day/yr sample was submitted _____
 Water Well Disinfected? Yes No _____

5 TYPE OF BLANK CASING USED:
 1 Steel 3 RMP (SR) 5 Wrought iron 8 Concrete tile CASING JOINTS: Glued Clamped _____
 2 PVC 4 ABS 7 Fiberglass _____ Welded _____
 Blank casing diameter 5 1/2 in. to 116 ft. Dia _____ in. to _____ ft. Dia _____ in. to _____ ft.
 Casing height above land surface 2' in. weight 268 lbs./ft. Wall thickness or gauge No. 265

TYPE OF SCREEN OR PERFORATION MATERIAL:
 1 Steel 3 Stainless steel 5 Fiberglass 8 RMP (SR) 10 Asbestos-cement 11 Other (specify) _____
 2 Brass 4 Galvanized steel 6 Concrete tile 9 ABS 12 None used (open hole)
 SCREEN OR PERFORATION OPENINGS ARE:
 1 Continuous slot 3 Mill slot 5 Gauzed wrapped Saw cut 11 None (open hole)
 2 Louvered shutter 4 Key punched 6 Wire wrapped 9 Drilled holes
 7 Torch cut 10 Other (specify) _____

SCREEN-PERFORATED INTERVALS: From 116 ft. to 136 ft., From _____ ft. to _____ ft.
 From _____ ft. to _____ ft., From _____ ft. to _____ ft.
 GRAVEL PACK INTERVALS: From 23 ft. to 136 ft., From _____ ft. to _____ ft.
 From _____ ft. to _____ ft., From _____ ft. to _____ ft.

6 GROUT MATERIAL: 1 Neat cement 2 Cement grout Bentonite 4 Other _____
 Grout Intervals: From 0 ft. to 23 ft., From _____ ft. to _____ ft., From _____ ft. to _____ ft.
 What is the nearest source of possible contamination:
 1 Septic tank 4 Lateral lines 7 Pit privy 10 Livestock pens 14 Abandoned water well
 2 Sewer lines 5 Cess pool 8 Sewage lagoon 11 Fuel storage 15 Oil well/Gas well
 3 Watertight sewer lines 6 Seepage pit 9 Feedyard 12 Fertilizer storage ~~13~~ Other (specify below) Gravel pit
 13 Insecticide storage
 Direction from well? East NE How many feet? 3700'

FROM	TO	LITHOLOGIC LOG	FROM	TO	PLUGGING INTERVALS
0	35	clay			
35	45	cemented sand			
45	99	sand & gravel			
99	105	cemented sand			
105	122	clay with sand strips			
122	135	sand			
135	136	5 hole			
		117 wL			

7 CONTRACTOR'S OR LANDOWNER'S CERTIFICATION: This water well was (1) constructed, (2) reconstructed, or (3) plugged under my jurisdiction and was completed on (mo/day/year) 12 13 05 and this record is true to the best of my knowledge and belief. Kansas
 Water Well Contractor's License No. 213 This Water Well Record was completed on (mo/day/yr) 12-19-05
 under the business name of Kemp's Well Service by (signature) George Kemp