

USE TYPEWRITER OR BALL POINT PEN—PRESS FIRMLY, PRINT CLEARLY.

WELL FROM [unclear]

WATER WELL RECORD
KSA 82a-1201-1215

Kansas Department of Health and Environment—Division of Environment
(Water well Contractors)
Topeka, Kansas 66620

BAA

1. Location of well: County Sherman Fraction NE NE Section number 30 Township number T 10 Range number S R 39


2. Distance and direction from nearest town or city: 9.5 W 2 S
Street address of well location if in city: of Great Western Sugar Co.
3. Owner of well: Blanche Petersen & Glen Flecher Estate
R.R. or street:
City, state, zip code:

4. Locate with "X" in section below: Sketch map:

6. Bore hole dia. 10 3/4 in. Completion date 6-17-77
Well depth 96 ft.
7. Cable tool Rotary Driven Dug
 Hollow rod Jetted Bored Reverse rotary
8. Use: Domestic Public supply Industry
 Irrigation Air conditioning Stock
 Lawn Oil field water Other
9. Casing: Material Steel Height: Above or below
Threaded Welded Surface 72 in.
RMP PVC Weight 17.6 lbs./ft.
Dia. 12 in. to 96 ft. depth Wall Thickness: inches or
Dia. in. to ft. depth gage No. 188

5. Type and color of material	From	To
Clay Gravel & Sandstone	0	45
Gravel	45	48
Clay & Sandstone	48	75
Gravel	75	77
Sandstone	77	78
Gravel	78	80
Clay & Sandstone	80	92
Gravel	92	94
Saapestone	94	96
Shale	96	100
<u>Brook 94'</u>		

10. Screen: Manufacturer's name DAERR
Type Mill Salt Dia. 4 1/2
Slot/gauze 132 Length 20
Set between 76 ft. and 96 ft.
Gravel pack? Size range of material 3/8
11. Static water level: 45 ft. below land surface Date 6-16-77 mo./day/yr.
12. Pumping level below land surfaces:
50 ft. after 2 hrs. pumping 3 g.p.m.
Estimated maximum yield 12 g.p.m.
13. Water sample submitted: Yes No Date
14. Well head completion: NONE
 Pitless adapter _____ inches above grade
15. Well grouted?
With: Neat cement Bentonite Concrete
Depth: From 17 ft. to 10 ft.
16. Nearest source of possible contamination:
ft. _____ Direction _____ Type _____
Well disinfected upon completion? Yes No
17. Pump: Not installed
Manufacturer's name _____ HP _____ Volts _____
Length of drop pipe _____ ft. capacity _____ g.p.m.
Type: Submersible Turbine
 Jet Reciprocating
 Centrifugal WINDMILL Other _____

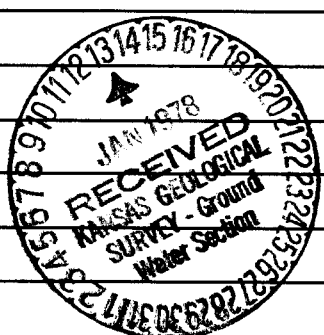

18. Elevation: _____
19. Remarks: Windmill was set by Foust Supply Co Inc.
Topography: Hill Slope Upland Valley

20. Water well contractor's certification:
This well was drilled under my jurisdiction and this report is true to the best of my knowledge and belief.
Foust Supply Co. No. 144
Business name _____ License No. _____
Address Goodland, KANS
Signed Ralph Sherman Date 6-17-77
Authorized representative

L 0 3 2 0 3 0 NE NE NW
1/4 1/4 1/4 1/4