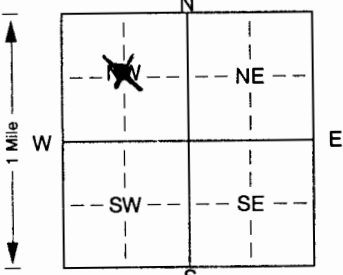


1 LOCATION OF WATER WELL: Fraction near 1/4 center 1/4 NW 1/4 Section Number 34 Township Number T 10 S Range Number R 4 X/W
 County: Ottawa
 Distance and direction from nearest town or city street address of well if located within city?
1 mile North & 3 miles West of Minneapolis, KS

2 WATER WELL OWNER: Steve Baccus
 RR#, St. Address, Box #: 707 N. 3rd Ave. Board of Agriculture, Division of Water Resources
 City, State, ZIP Code: Minneapolis, KS 67467 Application Number: 44,791

3 LOCATE WELL'S LOCATION WITH AN "X" IN SECTION BOX:

 4 DEPTH OF COMPLETED WELL: 118 ft. ELEVATION:
 Depth(s) Groundwater Encountered 1. ft. 2. ft. 3. ft.
 WELL'S STATIC WATER LEVEL ... 21 ... ft. below land surface measured on mo/day/yr ... 3/27/02 ...
 Pump test data: Well water was ... 78 ... ft. after ... 2 ... hours pumping ... 825 ... gpm
 Est. Yield 1000 - 1200 gpm: Well water was ... ft. after ... hours pumping ... gpm
 Bore Hole Diameter: ... 30 ... in. to ... 1.19 ... ft., and ... in. to ... ft.
 WELL WATER TO BE USED AS: 5 Public water supply 8 Air conditioning 11 Injection well
 1 Domestic 3 Feedlot 6 Oil field water supply 9 Dewatering 12 Other (Specify below)
 Irrigation 4 Industrial 7 Domestic (lawn & garden) 10 Monitoring well
 Was a chemical/bacteriological sample submitted to Department? Yes. No. ... ; If yes, mo/day/yrs sample was submitted
 Water Well Disinfected? Yes No

5 TYPE OF BLANK CASING USED:
 1 Steel 3 RMP (SR) 5 Wrought iron 8 Concrete tile CASING JOINTS: Glued. ... Clamped.
 PVC 4 ABS 7 Fiberglass Welded
 Threaded
 Blank casing diameter ... 16 ... in. to ... 38 ... ft., Dia ... in. to ... ft., Dia ... in. to ... ft.
 Casing height above land surface ... 12 ... in., weight ... 16.15 ... lbs./ft. Wall thickness or gauge No. ... 500
 TYPE OF SCREEN OR PERFORATION MATERIAL: PVC 10 Asbestos-cement
 1 Steel 3 Stainless steel 5 Fiberglass 8 RMP (SR) 11 Other (specify)
 2 Brass 4 Galvanized steel 6 Concrete tile 9 ABS 12 None used (open hole)
 SCREEN OR PERFORATION OPENINGS ARE: 5 Gauzed wrapped 8 Saw cut 11 None (open hole)
 1 Continuous slot Mill slot 6 Wire wrapped 9 Drilled holes
 2 Louvered shutter 4 Key punched 7 Torch cut 10 Other (specify) ft.
 SCREEN-PERFORATED INTERVALS: From ... 38 ... ft. to ... 118 ... ft., From ... ft. to ... ft.
 From ... ft. to ... ft., From ... ft. to ... ft.
 GRAVEL PACK INTERVALS: From ... 31 ... ft. to ... 118 ... ft., From ... ft. to ... ft.
 From ... ft. to ... ft., From ... ft. to ... ft.

6 GROUT MATERIAL: 1 Neat cement Cement grout 3 Bentonite 4 Other
 Grout Intervals: From ... 0 ... ft. to ... 31 ... ft., From ... ft. to ... ft., From ... ft. to ... ft.
 What is the nearest source of possible contamination: None within 1/4 mile
 1 Septic tank 4 Lateral lines 7 Pit privy 10 Livestock pens 14 Abandoned water well
 2 Sewer lines 5 Cess pool 8 Sewage lagoon 11 Fuel storage 15 Oil well/Gas well
 3 Watertight sewer lines 6 Seepage pit 9 Feedyard 12 Fertilizer storage 16 Other (specify below)
 13 Insecticide storage
 Direction from well? How many feet?

FROM	TO	LITHOLOGIC LOG	FROM	TO	PLUGGING INTERVALS
0	4	Topsoil			
4	18	Clay, brown			
18	34	Clay, sandy, gray			
34	51	Sand, medium to coarse with gravel			
51	53	Shale, gray			
53	72	Sandstone, white			
72	73	Iron Pyrite			
73	117	Sandstone, white			
117	119	Iron Pyrite			

7 CONTRACTOR'S OR LANDOWNER'S CERTIFICATION: This water well was constructed, (2) reconstructed, or (3) plugged under my jurisdiction and was completed on (mo/day/year) ... 3/28/02 ... and this record is true to the best of my knowledge and belief. Kansas Water Well Contractor's Licence No. ... 138 ... This Water Well Record was completed on (mo/day/yr) ... 3/29/02 ... under the business name of Peterson Irrigation, Inc. by (signature) Mike Peters