

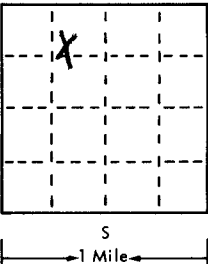
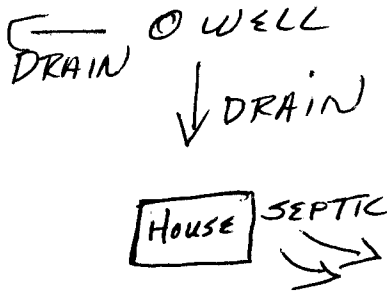
USE TYPEWRITER OR BALL POINT PEN-PRESS FIRMLY, PRINT CLEARLY.

10 4 W 25 W NW
T R EW sec 1/4 1/4 1/4 No.

WATER WELL RECORD
KSA 82a-1201-1215

SU4 NE4

Kansas State Dept. Of Health
(Water Well Contractors)
Forbes-Bldg. 740
Topeka, Kansas 66620

1 Location of well:	County OTTAWA	Township name GARFIELD	Fraction NW 1/4	Section number 2	Town number T10 S	Range number R4 W
Distance and direction from nearest town or city: 4 SOUTH Street address of well location if in city: EAST OF DELPHOS				3 Owner of well: RICHARD BARTLETT Address: MINNEAPOLIS, KANSAS		
Locate with "X" in section below: N  W E S 1 Mile		Sketch map: 		4 Well depth: 80 ft. Date of completion 9/17/75 Well diameter 8 in.		
2 Type and color of material		From To		5 <input type="checkbox"/> Cable tool <input checked="" type="checkbox"/> Rotary <input type="checkbox"/> Driven <input type="checkbox"/> Dug <input type="checkbox"/> Hollow rod <input type="checkbox"/> Jetted <input type="checkbox"/> Bored <input type="checkbox"/> Reverse rotary		
				6 Use: <input checked="" type="checkbox"/> Domestic <input type="checkbox"/> Public supply <input type="checkbox"/> Industry <input type="checkbox"/> Irrigation <input type="checkbox"/> Air conditioning <input type="checkbox"/> Commercial <input type="checkbox"/> Test well		
TOPSOIL 0 2		BROWN CLAY 2 15		7 Casing: Material PVC Height: above below Threaded <input type="checkbox"/> Welded <input checked="" type="checkbox"/> Surface 12 in. Diam. 3 lbs./ft. 5 in. to 80 ft. depth Drive shoe? <input type="checkbox"/> Yes <input checked="" type="checkbox"/> No		
				8 Screen: Manufacturer CERTAINTEED Dia. 8 PVC Slot/gauze 1/16" Length 20' Set between 80 ft. and 75 ft. 40-50 Fittings: Gravel pack <input checked="" type="checkbox"/> Yes <input type="checkbox"/> No Size range of material 1/4"		
SANDY CLAY 15 19		GRAVEL 19 40		9 Static water level: 32 ft. below land surface Date 9/17/75		
				10 Pumping level below land surfaces: NO PUMPING TEST ft. after hrs. pumping g.p.m. ft. after hrs. pumping g.p.m. Estimated maximum yield 4 g.p.m.		
GRAY CLAY 40 80		STOP 80		11 Water sample submitted: <input type="checkbox"/> Yes <input checked="" type="checkbox"/> No Date _____		
				12 Well head completion: <input type="checkbox"/> Pitless adapter <input checked="" type="checkbox"/> Inches above grade		
				13 Well grouted? <input checked="" type="checkbox"/> Yes <input type="checkbox"/> No <input checked="" type="checkbox"/> Neat cement <input type="checkbox"/> Bentonite <input type="checkbox"/> _____ Depth: From 0 ft. to 10 ft.		
				14 Nearest source of possible contamination: ft. 100 Direction SOUTH Type SEPTIC TANK Well disinfected upon completion? <input checked="" type="checkbox"/> Yes <input type="checkbox"/> No		
				15 Pump: <input checked="" type="checkbox"/> Not installed Manufacturer's name _____ Model number _____ HP _____ Volts _____ Length of drop pipe _____ ft. capacity _____ g.p.m. Type: <input type="checkbox"/> Submersible <input type="checkbox"/> Turbine <input type="checkbox"/> Jet <input type="checkbox"/> Reciprocating <input type="checkbox"/> Centrifugal <input type="checkbox"/> Other		
				16 Remarks: elevation CONCRETE SLAB TO BE INSTALLED BY CUSTOMER		
				17 Water well contractor's certification: This well was drilled under my jurisdiction and this report is true to the best of my knowledge and belief. GEO COX + SONS INC 258 Business name License No. _____ Address GEO COX + SONS INC Signed Larry Cox Date 9/18/75 Authorized representative		

10 4 W 25 W NW

Forward the white, blue and pink copies to the Kansas State Dept. Of Health.

Form WWC-5