

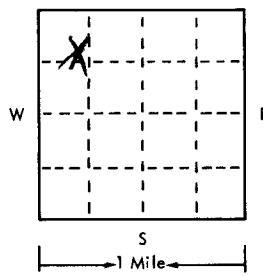
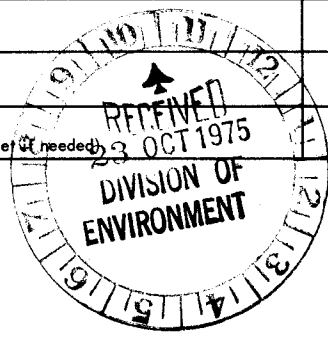
USE TYPEWRITER OR BALL POINT PEN-PRESS FIRMLY, PRINT CLEARLY.

10 4 W 2 P E M W
T R EW sec 1/4 1/4 1/4 No.

WATER WELL RECORD
KSA 82a-1201-1215

Kansas State Dept. Of Health
(Water Well Contractors)
Forbes-Bldg. 740
Topeka, Kansas 66620

SE 1/4 NW 1/4

1 Location of well:		County OTTOWA	Township name GARFIELD	Fraction NW 1/4	Section number 2	Town number T10 S	Range number R4 W
Distance and direction from nearest town or city: 4 SOUTH Street address of well location if in city: 1 EAST OF DELPHOS				3 Owner of well: RICHARD BARTLETT Address: MINNEAPOLIS, KANSAS			
Locate with "X" in section below: N  W E S 1 Mile		Sketch map: OR 500' SEPTIC TANK → HOUSE ↓ DRIVE		4 Well depth: 157 ft. Date of completion 10/15/75 Well diameter 8 in.			
2 Type and color of material		From	To	5 <input type="checkbox"/> Cable tool <input checked="" type="checkbox"/> Rotary <input type="checkbox"/> Driven <input type="checkbox"/> Dug <input type="checkbox"/> Hollow rod <input type="checkbox"/> Jetted <input type="checkbox"/> Bored <input type="checkbox"/> Reverse rotary			
TOPSOIL		0	2	6 Use: <input checked="" type="checkbox"/> Domestic <input type="checkbox"/> Public supply <input type="checkbox"/> Industry <input type="checkbox"/> Irrigation <input type="checkbox"/> Air conditioning <input type="checkbox"/> Commercial <input type="checkbox"/> Test well			
BROWN CLAY		2	10	7 Casing: Material PVC Height: above below Threaded <input type="checkbox"/> Welded <input checked="" type="checkbox"/> Surface 1 1/2 in. Diam. 5 in. Weight 3 lbs./ft. 5 in. to 157 ft. depth! Drive shoe? <input type="checkbox"/> Yes <input checked="" type="checkbox"/> No — in. to — ft. depth!			
SAND		10	20	8 Screen: Manufacturer CERTAINTEED PVC SLOTTED Dia. 5 Slot gauze 7/16" Length 20' Set between 137 ft. and 137 ft. Fittings: Gravel pack <input checked="" type="checkbox"/> Yes <input type="checkbox"/> No Size range of material 1/4" - 1/2"			
GRAVEL		20	29	9 Static water level: 40 ft. below land surface Date 10/15/75			
GRAY CLAY		29	75	10 Pumping level below land surface: NO TEST — ft. after — hrs. pumping — g.p.m. — ft. after — hrs. pumping — g.p.m. Estimated maximum yield 50 g.p.m.			
CLAY W/ ROCK LAYERS		75	93	11 Water sample submitted: <input type="checkbox"/> Yes <input checked="" type="checkbox"/> No Date —			
ROCK		93	94	12 Well head completion: <input type="checkbox"/> Pitless adapter <input checked="" type="checkbox"/> Inches above grade			
GRAY CLAY		94	97	13 Well grouted? <input checked="" type="checkbox"/> Yes <input type="checkbox"/> No <input checked="" type="checkbox"/> Neat cement <input type="checkbox"/> Bentonite <input type="checkbox"/> Depth: From 0 ft. to 10 ft.			
SANDROCK		97	106	14 Nearest source of possible contamination: ft. 500 Direction NE Type LOTS Well disinfected upon completion? <input checked="" type="checkbox"/> Yes <input type="checkbox"/> No			
GRAY CLAY		106	124	15 Pump: <input checked="" type="checkbox"/> Not installed Manufacturer's name _____ Model number _____ HP _____ Volts _____ Length of drop pipe _____ ft. capacity _____ g.m.p. Type: <input type="checkbox"/> Submersible <input type="checkbox"/> Turbine <input type="checkbox"/> Jet <input type="checkbox"/> Reciprocating <input type="checkbox"/> Centrifugal <input type="checkbox"/> Other			
GRAY CLAY		124	160	17 Water well contractor's certification: This well was drilled under my jurisdiction and this report is true to the best of my knowledge and belief. BOB COX & SONS INC 258 Business name _____ License No. _____ Address WILTON, KANSAS Signed BOB COX Date 10/15/75 Authorized representative			
16 Remarks: elevation 1290 Topography: <input type="checkbox"/> Hill <input type="checkbox"/> Slope <input checked="" type="checkbox"/> Upland <input type="checkbox"/> Valley		(use a second sheet if needed)					

10 4 W 2 SE NW NW

Forward the white, blue and pink copies to the Kansas State Dept. Of Health.

Form WWC-5