WATER WELL RECORD Form WWC-5 KSA 82a-1212

**1 LOCATION OF WATER WELL:** County: Ottawa

Fraction: NE ¼ NE ¼ SE ¼ | Section Number: 32 | Township Number: T 10 S | Range Number: R 4W E/W

Distance and direction from nearest town or city street address of well if located within city?
from Minneapolis, 3/4 m N.W., 1 mile N, 3 miles W, 1/4 m South

**2 WATER WELL OWNER:** Gary Plunkett
RR#, St. Address, Box # : Route 1
City, State, ZIP Code : Minneapolis, KS 67467

Board of Agriculture, Division of Water Resources Application Number:

**3 LOCATE WELL'S LOCATION WITH AN "X" IN SECTION BOX:**

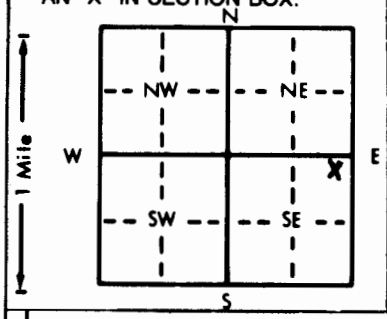


**4 DEPTH OF COMPLETED WELL** 100' ft. ELEVATION: 1252

Depth(s) Groundwater Encountered 1. 80' ft. 2. ft. 3. ft.

WELL'S STATIC WATER LEVEL 78' ft. below land surface measured on mo/day/yr 12-6-88

Pump test data: Well water was 99 ft. after 3/4 hours pumping 20 gpm

Est. Yield 20 gpm: Well water was ft. after hours pumping gpm

Bore Hole Diameter 8" in. to 100' ft., and in. to ft.

WELL WATER TO BE USED AS: 1 Domestic 2 Irrigation 3 Feedlot 4 Industrial 5 Public water supply 6 Oil field water supply 7 Lawn and garden only 8 Air conditioning 9 Dewatering 10 Observation well 11 Injection well 12 Other (Specify below)

Was a chemical/bacteriological sample submitted to Department? Yes ..... No X ; If yes, mo/day/yr sample was submitted

Water Well Disinfected? Yes X No

**5 TYPE OF BLANK CASING USED:** 1 Steel 2 PVC 3 RMP (SR) 4 ABS 5 Wrought iron 6 Asbestos-Cement 7 Fiberglass 8 Concrete tile 9 Other (specify below)

CASING JOINTS: Glued X Clamped Welded Threaded

Blank casing diameter 5" in. to 90 ft., Dia in. to ft., Dia in. to ft.

Casing height above land surface 12 in., weight 3/4 lbs./ft. Wall thickness or gauge No. .258

TYPE OF SCREEN OR PERFORATION MATERIAL: 1 Steel 2 Brass 3 Stainless steel 4 Galvanized steel 5 Fiberglass 6 Concrete tile 7 PVC 8 RMP (SR) 9 ABS 10 Asbestos-cement 11 Other (specify) 12 None used (open hole)

SCREEN OR PERFORATION OPENINGS ARE: 1 Continuous slot 2 Louvered shutter 3 Mill slot 4 Key punched 5 Gauzed wrapped 6 Wire wrapped 7 Torch cut 8 Saw cut 9 Drilled holes 10 Other (specify) 11 None (open hole)

SCREEN-PERFORATED INTERVALS: From 90 ft. to 100 ft., From ft. to ft.
From ft. to ft., From ft. to ft.

GRAVEL PACK INTERVALS: From 20 ft. to 100 ft., From ft. to ft.
From ft. to ft., From ft. to ft.

**6 GROUT MATERIAL:** 1 Neat cement 2 Cement grout 3 Bentonite 4 Other

Grout Intervals: From 0 ft. to 20 ft., From ft. to ft., From ft. to ft.

What is the nearest source of possible contamination: 1 Septic tank 2 Sewer lines 3 Watertight sewer lines 4 Lateral lines 5 Cess pool 6 Seepage pit 7 Pit privy 8 Sewage lagoon 9 Feedyard 10 Livestock pens 11 Fuel storage 12 Fertilizer storage 13 Insecticide storage 14 Abandoned water well 15 Oil well/Gas well 16 Other (specify below)

Direction from well? North How many feet? 60'

| FROM | TO | LITHOLOGIC LOG | FROM | TO | LITHOLOGIC LOG |
|---|---|---|---|---|---|
| 0 | 20 | Top Soil & Clay | | | |
| 20 | 80 | Gray Clay | | | |
| 80 | 100 | Sandrock | | | |
| 100 | | Red Clay - Stopped | | | |

**7 CONTRACTOR'S OR LANDOWNER'S CERTIFICATION:** This water well was (1) constructed, (2) reconstructed, or (3) plugged under my jurisdiction and was completed on (mo/day/year) 12-6-88 and this record is true to the best of my knowledge and belief. Kansas Water Well Contractor's License No. 361 This Water Well Record was completed on (mo/day/yr) 06-23-89 under the business name of Cox-Beswick Irrigation Service, Inc. by (signature) Annie Beswick

INSTRUCTIONS: Use typewriter or ball point pen. *PLEASE PRESS FIRMLY* and *PRINT* clearly. Please fill in blanks, underline or circle the correct answers. Send top three copies to Kansas Department of Health and Environment, Bureau of Water Protection, Topeka, Kansas 66620-7320, Telephone: 913-862-9360. Send one to WATER WELL OWNER and retain one for your records.

OFFICE USE ONLY T R E/W SEC. ¼ ¼ ¼