


1	LOCATION OF WATER WELL:	Fraction	Section Number	Township Number	Range Number
County:	SHERMAN	NE 1/4 NW 1/4 NE 1/4	6	10S	40W E/W

Distance and direction from nearest town or city street address of well if located within city?

2 WATER WELL OWNER: DONALD A CALDWELL
 RR #, St. Address, Box #: 48518 SNEAD DRIVE Board of Agriculture, Division of Water Resources
 City, State, ZIP Code : BURLINGTON CO 80807 Application Number: 15635-00

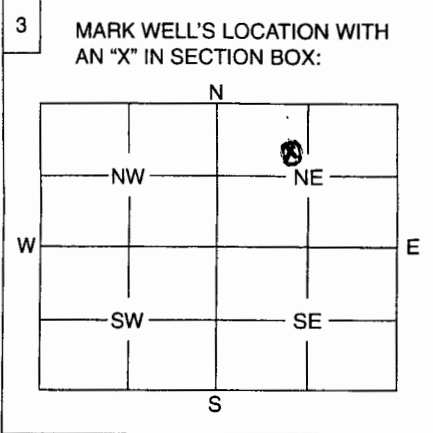

4 DEPTH OF WELL 321 ft.
 WELL'S STATIC WATER LEVEL 161 ft.
 WELL WAS USED AS:
 1 Domestic 5 Public Water Supply 9 Dewatering
 2 Irrigation 6 Oil Field Water Supply 10 Monitoring Well
 3 Feedlot 7 Domestic (Lawn & Garden) 11 Injection Well
 4 Industrial 8 Air Conditioning 12 Other

Was a chemical / bacteriological sample submitted to Department? Yes No X.....
 If yes, mo/day/yr sample was submitted

Water Well Disinfected: Yes X..... No

4# HTH

5 TYPE OF BLANK CASING USED:
 1 Steel 3 RMP (SR) 5 Wrought 7 Fiberglass 9 Other (Specify below)
 2 PVC 4 ABS 6 Asbestos-Cement 8 Concrete Tile

Blank casing diameter 16 in. Was casing pulled? Yes X..... No If yes, how much 7'
 Casing height above of below land surface 84 in.

6 GROUT PLUG MATERIAL: 1 Neat cement 2 Cement grout 3 Bentonite 4 Other

Grout Plug Intervals: From 150 ft. to 145 ft., From 10 ft. to 7 ft., From 7 to 5 ft.

What is the nearest source of possible contamination:
 1 Septic tank 6 Seepage pit 11 Fuel storage 16 Other (specify below)
 2 Sewer lines 7 Pit privy 12 Fertilizer storage FARMSTEAD
 3 Watertight sewer lines 8 Sewage lagoon 13 Insecticide storage
 4 Lateral lines 9 Feedyard 14 Abandoned water well
 5 Cess pool 10 Livestock pens 15 Oil well/Gas well

Direction from well? WEST How many feet? 3/4 Mile

FROM	TO	PLUGGING MATERIALS
321'	150'	Chlorinated gravel (237cubic feet)
150'	146'	Bentonite Crumbles (10bags)
146'	10'	Native Clays (189 cubic feet)
10'	7'	Bentonite chips (7bags)
7'	7'	1/4" Steel plate welded solid to casing
7'	5'	Bentonite chips (10 bags) Packed around bore hole
5'	0'	Native clays, backfilled to surface

7 CONTRACTOR'S OF LANDOWNER'S CERTIFICATION: This water well was plugged under my jurisdiction and was completed on (mo/day/year) 5-01-06 and this record is true to the best of my knowledge and belief. Kansas Water Well Contractor's License No. 633 This Water Well Record was completed on (mo/day/year) 5-15-06 under the business name of DMW WELL & PUMP SERVICE by (signature) Jerry T. [Signature]

INSTRUCTIONS: Use typewriter or ball point pen. Please press firmly and print clearly. Please fill in blanks, underline or circle the correct answers. Send top three copies to Kansas Department of Health and Environment, Bureau of Water, Geology Section, 1000 SW Jackson St., Ste. 420, Topeka, Kansas 66612-1367. Telephone: 785/296-5522. Send one to Water Well Owner and retain one for your records.