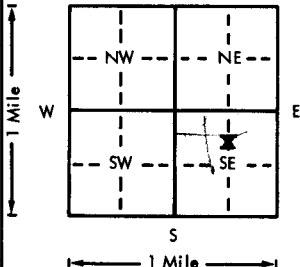


USE TYPEWRITER OR BALL
POINT PEN-PRESS FIRMLY,
PRINT CLEARLY.

WATER WELL RECORD
KSA 82a-1201-1215

Kansas Department of Health and
Environment-Division of Environment
(Water well Contractors)
Topeka, Kansas 66620

1. Location of well:		County Sherman	Fraction of section Center of west side of NE 1/4	Section number 5	Township number T 10 S R 40	Range number 40
2. Distance and direction from nearest town or city: 7 miles south, 4 west, 1 1/4 south of Goodland, Kansas Street address of well location if in city:				3. Owner of well: Richard Emig R.R. or street: City, state, zip code: Goodland, Kansas 67735		
4. Locate with "X" in section below:		Sketch map:		6. Bore hole dia. 30 in. Completion date 4-19-76 Well depth 295 ft.		
		Center of west side of NE 1/4, SE 1/4, Sec. 5, Twp. 10, Rge. 40		7. Cable tool <input type="checkbox"/> Rotary <input type="checkbox"/> Driven <input type="checkbox"/> Dug Hollow rod <input type="checkbox"/> Jetted <input type="checkbox"/> Bored <input checked="" type="checkbox"/> Reverse rotary		
5. Type and color of material				From	To	8. Use: Domestic <input type="checkbox"/> Public supply <input type="checkbox"/> Industry <input checked="" type="checkbox"/> Irrigation <input type="checkbox"/> Air conditioning <input type="checkbox"/> Stock <input type="checkbox"/> Lawn <input type="checkbox"/> Oil field water <input type="checkbox"/> Other
sand clay and rock				0	131	9. Casing: Material steel Height: Above or below Threaded <input type="checkbox"/> Welded <input checked="" type="checkbox"/> Surface 12 in. RMP <input type="checkbox"/> PVC <input type="checkbox"/> Weight 36 lbs./ft.
medium sands loose clean				131	138	Dia. 16 in. to 295 ft. depth Wall Thickness: inches or Dia. <input type="checkbox"/> in. to <input type="checkbox"/> ft. depth gage No. 219
sand rock				138	143	10. Screen: Manufacturer's name W. A. Brown Type steel Dia. 16" Slot/gauze 2" Length 100 Set between 195 ft. and 295 ft. Gravel pack? yes Size range of material 3/8
medium sands				143	147	11. Static water level: 120 ft. below land surface Date 5-8-76
sand rock and clay				147	180	12. Pumping level below land surfaces: 240 ft. after 8 hrs. pumping 1200 g.p.m. ft. after <input type="checkbox"/> hrs. pumping <input type="checkbox"/> g.p.m. Estimated maximum yield 1200 g.p.m.
medium sands loose clean				180	187	13. Water sample submitted: no mo./day/yr. Yes <input type="checkbox"/> No <input checked="" type="checkbox"/> Date
bentonite				187	231	14. Well head completion: Pitless adapter 12 inches above grade
rock clay and sand rock				231	275	15. Well grouted? yes With: <input checked="" type="checkbox"/> Neat cement <input type="checkbox"/> Bentonite <input type="checkbox"/> Concrete Depth: From 0 ft. to 10 ft.
soapstone				275	292	16. Nearest source of possible contamination: none ft. Direction Type Well disinfected upon completion? <input type="checkbox"/> Yes <input checked="" type="checkbox"/> No
blue				292	295	17. Pump: <input type="checkbox"/> Not installed Manufacturer's name Byron Jackson Model number <input type="checkbox"/> HP <input type="checkbox"/> Volts Length of drop pipe 280 ft. capacity 1200 g.p.m. Type: <input type="checkbox"/> Submersible <input checked="" type="checkbox"/> Turbine <input type="checkbox"/> Jet <input type="checkbox"/> Reciprocating <input type="checkbox"/> Centrifugal <input type="checkbox"/> Other
(Use a second sheet if needed)						20. Water well contractor's certification: This well was drilled under my jurisdiction and this report is true to the best of my knowledge and belief. Northwest Drilling Co., Inc. Business name License No. 6781 Address Box 411, Goodland, Ks Signed Ben Harris Date 6-15-76 Authorized representative
18. Elevation:		19. Remarks:				
Topography: <input type="checkbox"/> Hill <input checked="" type="checkbox"/> Slope <input type="checkbox"/> Upland <input type="checkbox"/> Valley		3750 (TOPO) 3754				