


1 LOCATION OF WATER WELL: County: Sherman Fraction: NW 1/4 SE 1/4 SW 1/4 Section Number: 10 Township Number: T 10 S Range Number: R 40 EW

Distance and direction from nearest town or city street address of well if located within city?
2 West 850' of Goodland KS.

2 WATER WELL OWNER: Roy Hinkle
 RR#, St. Address, Box #: RT Board of Agriculture, Division of Water Resources
 City, State, ZIP Code: Goodland KS, 67735 Application Number:

3 LOCATE WELL'S LOCATION WITH AN "X" IN SECTION BOX:

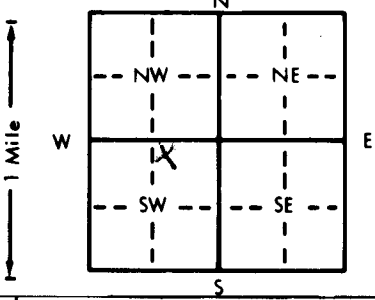

4 DEPTH OF COMPLETED WELL: 105 ft. ELEVATION: 3400
 Depth(s) Groundwater Encountered 1. 66 ft. 2. . ft. 3. . ft.
 WELL'S STATIC WATER LEVEL 6.5 ft. below land surface measured on mo/day/yr 4-4-91
 Pump test data: Well water was . ft. after . hours pumping . gpm
 Est. Yield 10 gpm: Well water was . ft. after . hours pumping . gpm
 Bore Hole Diameter 8 in. to 10.5 ft., and . in. to . ft.
 WELL WATER TO BE USED AS:
 5 Public water supply 8 Air conditioning 11 Injection well
 1 Domestic 3 Feedlot 6 Oil field water supply 9 Dewatering 12 Other (Specify below)
 2 Irrigation 4 Industrial 7 Lawn and garden only 10 Monitoring well Stock
 Was a chemical/bacteriological sample submitted to Department? Yes . No X; If yes, mo/day/yr sample was submitted .
 Water Well Disinfected? Yes X No

5 TYPE OF BLANK CASING USED:
 1 Steel 3 RMP (SR) 5 Wrought iron 8 Concrete tile CASING JOINTS: Glued Clamped
 2 PVC 4 ABS 6 Asbestos-Cement 9 Other (specify below) Welded
 7 Fiberglass Threaded
 Blank casing diameter 4 in. to 9.5 ft., Dia . in. to . ft., Dia . in. to . ft.
 Casing height above land surface 12 in., weight 1.84 lbs./ft. Wall thickness or gauge No. SDR 21
 TYPE OF SCREEN OR PERFORATION MATERIAL:
 1 Steel 3 Stainless steel 5 Fiberglass 8 RMP (SR) 10 Asbestos-cement
 2 Brass 4 Galvanized steel 6 Concrete tile 9 ABS 11 Other (specify)
 12 None used (open hole)
 SCREEN OR PERFORATION OPENINGS ARE:
 1 Continuous slot 2 Mill slot 5 Gauzed wrapped 8 Saw cut 11 None (open hole)
 2 Louvered shutter 4 Key punched 6 Wire wrapped 9 Drilled holes
 7 Torch cut 10 Other (specify)
 SCREEN-PERFORATED INTERVALS: From 9.5 ft. to 10.5 ft., From . ft. to . ft.
 From . ft. to . ft., From . ft. to . ft.
 GRAVEL PACK INTERVALS: From 0 ft. to 9.0 ft., From . ft. to . ft.
 From . ft. to . ft., From . ft. to . ft.

6 GROUT MATERIAL: 1 Neat cement 2 Cement grout 3 Bentonite 4 Other
 Grout intervals: From 2.5 ft. to 4 ft., From 4 ft. to 0 ft., From . ft. to . ft.
 What is the nearest source of possible contamination:
 1 Septic tank 4 Lateral lines 7 Pit privy 10 Livestock pens 14 Abandoned water well
 2 Sewer lines 5 Cess pool 8 Sewage lagoon 11 Fuel storage 15 Oil well/Gas well
 3 Watertight sewer lines 6 Seepage pit 9 Feedyard 12 Fertilizer storage 16 Other (specify below)
 13 Insecticide storage N.A.
 Direction from well? in PASTURE
 How many feet? 10

FROM	TO	LITHOLOGIC LOG	FROM	TO	PLUGGING INTERVALS
0	2	Top Soil			
2	43	Clay			
43	56	Sand & Gravel			
56	65	Clay			
65	66	Rock			
66	71	Gravel			
71	73	Rock			
73	83	Sand & Gravel			
83	89	Rock			
89	103	Sand			
103	105	Shale			

7 CONTRACTOR'S OR LANDOWNER'S CERTIFICATION: This water well was (1) constructed, (2) reconstructed, or (3) plugged under my jurisdiction and was completed on (mo/day/year) 3-19-91 and this record is true to the best of my knowledge and belief. Kansas Water Well Contractor's License No. 184 This Water Well Record was completed on (mo/day/yr) 4-8-91 under the business name of Schankogge Drilling Inc by (signature) Robert Schankogge