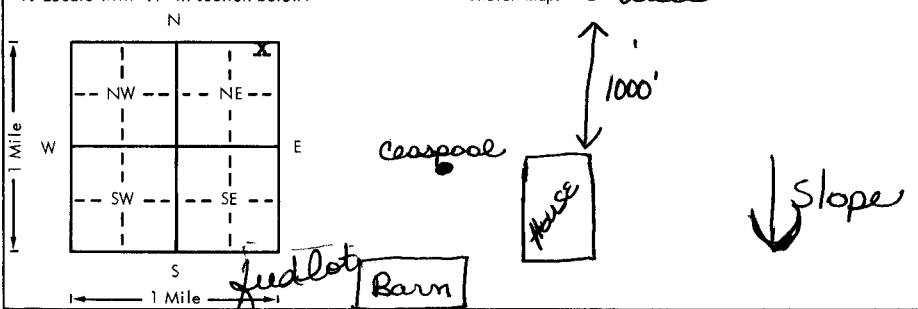


USE TYPEWRITER OR BALL
POINT PEN-PRESS FIRMLY,
PRINT CLEARLY.

WATER WELL RECORD
KSA 82a-1201-1215

Kansas Department of Health and
Environment-Division of Environment
(Water well Contractors)
Topeka, Kansas 66620

1. Location of well:		County Sherman	Fraction NE 1/4 NE 1/4 NE 1/4	Section number 12	Township number T 10 S	Range number R 40 E/W
2. Distance and direction from nearest town or city: 9 miles South of Goodland KS Street address of well location if in city:				3. Owner of well: Lyle Bedford R.R. or street: 414 East 8th City, state, zip code: Goodland, KS 67735		
4. Locate with "X" in section below: 				6. Bore hole dia. 8 in. Completion date _____ Well depth 60 ft. 10-17-79		
5. Type and color of material				7. <input checked="" type="checkbox"/> Cable tool <input checked="" type="checkbox"/> Rotary <input type="checkbox"/> Driven <input type="checkbox"/> Dug <input type="checkbox"/> Hollow rod <input type="checkbox"/> Jetted <input type="checkbox"/> Bored <input type="checkbox"/> Reverse rotary		
				8. Use: <input checked="" type="checkbox"/> Domestic <input type="checkbox"/> Public supply <input type="checkbox"/> Industry <input type="checkbox"/> Irrigation <input type="checkbox"/> Air conditioning <input type="checkbox"/> Stock <input type="checkbox"/> Lawn <input type="checkbox"/> Oil field water <input type="checkbox"/> Other		
Topsoil, Clay				9. Casing: Material Plastic Height: Above or below Threaded _____ Welded _____ Surface 12 in. RMP _____ PVC <input checked="" type="checkbox"/> Weight _____ lbs./ft. Dia. 4 in. to 48 ft. depth Wall Thickness: inches or Dia. _____ in. to _____ ft. depth gage No. 237		
				10. Screen: Manufacturer's name _____ Pearless Type Louver Dia. 5" Slot/gauze 1/8 .258 Length 12' Set between 48 ft. and 60 ft. _____ ft. and _____ ft. Gravel pack? yes Size range of material 1/8		
M. Gravel, Gravel				From	To	11. Static water level: _____ mo./day/yr. 28 ft. below land surface Date 10-17-79
Clay, Rock, Sand Stone				0	13	12. Pumping level below land surfaces: 43 ft. after 2 hrs. pumping 14 g.p.m. _____ ft. after _____ hrs. pumping _____ g.p.m. Estimated maximum yield 50 g.p.m.
M. Gravel, Sandy Clay				13	16	13. Water sample submitted: _____ mo./day/yr. <input type="checkbox"/> Yes <input checked="" type="checkbox"/> No Date _____
M. Gravel, Sand Stone				16	23	14. Well head completion: <input checked="" type="checkbox"/> Pitless adapter 12 Inches above grade
M. Gravel				23	26	15. Well grouted? yes With: <input checked="" type="checkbox"/> Neat cement <input type="checkbox"/> Bentonite <input type="checkbox"/> Concrete Depth: From 5 ft. to 15 ft.
M. Gravel, Sandy Clay				26	31	16. Nearest source of possible contamination: ft. 1,050 Direction South Type cesspool Well disinfected upon completion? <input checked="" type="checkbox"/> Yes <input type="checkbox"/> No
Hard Sand Stone				31	35	17. Pump: _____ Not installed Manufacturer's name not known Model number _____ HP 1/2 Volts 230 Length of drop pipe 58 ft. capacity 10 g.p.m. Type: <input checked="" type="checkbox"/> Submersible <input type="checkbox"/> Turbine <input type="checkbox"/> Jet <input type="checkbox"/> Reciprocating <input type="checkbox"/> Centrifugal <input type="checkbox"/> Other
M. Gravel, Hard Sand Stone				35	44	20. Water well contractor's certification: This well was drilled under my jurisdiction and this report is true to the best of my knowledge and belief. S & H Drilling 166 Business name _____ License No. _____ Address Goodland, KS 67735 Signed Bill Clifford Date 12-6-79 Authorized representative
Ochre, Shale				44	47	
BROCK 49				47	49	
				49	60	
(Use a second sheet if needed)						
18. Elevation:		19. Remarks:				
Topography: <input type="checkbox"/> Hill <input type="checkbox"/> Slope <input checked="" type="checkbox"/> Upland <input checked="" type="checkbox"/> Valley		3620				