

USE TYPEWRITER OR BALL POINT PEN—PRESS FIRMLY, PRINT CLEARLY.


700A

WATER WELL RECORD
KSA 82a-1201-1215

Kansas Department of Health and Environment—Division of Environment
(Water well Contractors)
Topeka, Kansas 66620

1. Location of well: County **Sherman** Fraction **NE 1/4 SW 1/4 NE 1/4** Section number **18** Township number **T 10 S R 40** Range number **40** E/W

2. Distance and direction from nearest town or city: **4 miles West 10 miles south of Goodland, Kansas**
Street address of well location if in city:
3. Owner of well: **Chester E. James**
R.R. or street:
City, state, zip code: **Burlington, Colorado 80807**

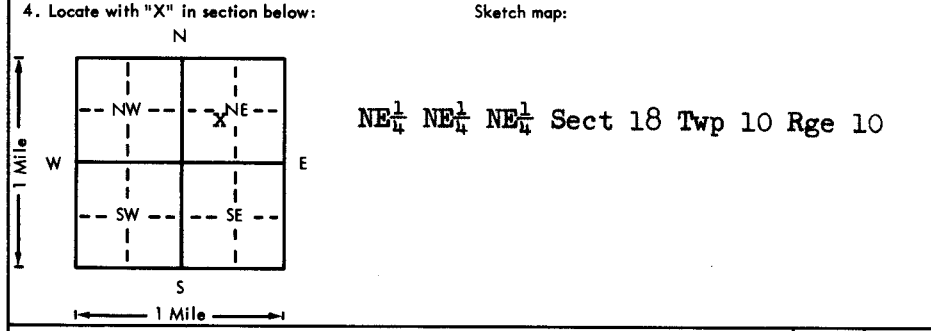

6. Bore hole dia. 30 in. Completion date _____
Well depth 235 ft. 10-5-75
7. Cable tool Rotary Driven Dug
 Hollow rod Jetted Bored Reverse rotary
8. Use: Domestic Public supply Industry
 Irrigation Air conditioning Stock
 Lawn Oil field water Other
9. Casing: Material steel Weight: Above or below
Threaded Welded Surface 12 in.
RMP PVC Weight 36 lbs./ft.
Dia. 16 in. to 235 ft. depth Wall Thickness: inches or
Dia. _____ in. to _____ ft. depth gage No. 219

5. Type and color of material sand top soil	From	To
sand coarse	20	54
clay	54	71
sandy clay	71	81
sandy clay, most sand	81	101
sandy clay most clay	101	121
sand coarse	121	141
sandy clay	141	151
sand coarse	151	171
sandy clay most part sand	171	191
sand fine	191	201
sand coarse	201	221
sand	221	231
clay	231	235
(Use a second sheet if needed)		

10. Screen: Manufacturer's name W. A. Brown Enterprises
Type steel Dia. 16
Slot/gauze 2" Length 100
Set between 130 ft. and 230 ft.
_____ ft. and _____ ft.
Gravel pack? Size range of material 3/4
11. Static water level: _____ mo./day/yr.
42 ft. below land surface Date 10-6-75
12. Pumping level below land surfaces:
140 ft. after 5 hrs. pumping 1400 g.p.m.
_____ ft. after _____ hrs. pumping _____ g.p.m.
Estimated maximum yield _____ g.p.m.
13. Water sample submitted: _____ mo./day/yr.
Yes No Date _____
14. Well head completion:
 Pitless adapter 12 Inches above grade
15. Well grouted? _____
With: Neat cement Bentonite Concrete
Depth: From 0 ft. to 12 ft.
16. Nearest source of possible contamination: none
ft. _____ Direction _____ Type _____
Well disinfected upon completion? Yes No
17. Pump: _____ Not installed
Manufacturer's name Gould
Model number Turbine HP 100 Volts _____
Length of drop pipe 180 ft. capacity 1400 g.p.m.
Type:
 Submersible Turbine
 Jet Reciprocating
 Centrifugal Other

18. Elevation: Topography: _____ Hill
 Slope
_____ Upland
_____ Valley

19. Remarks: 3725 (TOTO)

20. Water well contractor's certification:
This well was drilled under my jurisdiction and this report is true to the best of my knowledge and belief.
Northwest Drilling Co., Inc.
Business name / License No. _____
Address Scott, City, Kansas
Signed Ben Harris Date 12-2
Authorized representative

T 10 S R 40 NE NE NE