


1 LOCATION OF WATER WELL: Fraction SW 1/4 SW 1/4 NE 1/4 Section Number 22 Township Number T 10 S Range Number R 40 EW

Distance and direction from nearest town or city street address of well if located within city?
2 west 1 1/4 mi So of Goodland KS.

2 WATER WELL OWNER: Wm Sandy
 RR#, St. Address, Box #: RT. 2 Board of Agriculture, Division of Water Resources
 City, State, ZIP Code: Goodland, KS 67235 Application Number:

3 LOCATE WELL'S LOCATION WITH AN "X" IN SECTION BOX:

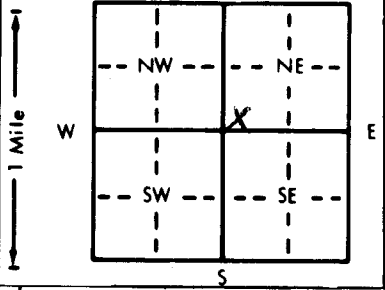

4 DEPTH OF COMPLETED WELL: 117 ft. ELEVATION: 3500
 Depth(s) Groundwater Encountered 1. 91 ft. 2. ft. 3. ft.
 WELL'S STATIC WATER LEVEL 91 ft. below land surface measured on mo/day/yr 9-6-81

Pump test data: Well water was _____ ft. after _____ hours pumping _____ gpm
 Est. Yield 5 gpm: Well water was _____ ft. after _____ hours pumping _____ gpm
 Bore Hole Diameter 8 in. to 1.17 ft., and _____ in. to _____ ft.
 WELL WATER TO BE USED AS: 5 Public water supply 8 Air conditioning 11 Injection well
 1 Domestic 3 Feedlot 6 Oil field water supply 9 Dewatering (2) Other (Specify below) Structure
 2 Irrigation 4 Industrial 7 Lawn and garden only 10 Monitoring well
 Was a chemical/bacteriological sample submitted to Department? Yes _____ No X; If yes, mo/day/yr sample was submitted _____ Water Well Disinfected? Yes X No

5 TYPE OF BLANK CASING USED: 5 Wrought iron 8 Concrete tile CASING JOINTS: Glued X Clamped _____
 1 Steel 3 RMP (SR) 6 Asbestos-Cement 9 Other (specify below) Welded _____
2 PVC 4 ABS 7 Fiberglass Threaded _____

Blank casing diameter 5 in. to 1.07 ft., Dia _____ in. to _____ ft., Dia _____ in. to _____ ft.
 Casing height above land surface 12 in., weight 2.81 lbs./ft. Wall thickness or gauge No. S.D.R. 21

TYPE OF SCREEN OR PERFORATION MATERIAL: 10 Asbestos-cement 11 Other (specify) _____
 1 Steel 3 Stainless steel 5 Fiberglass 7 PVC 8 RMP (SR) 12 None used (open hole)
 2 Brass 4 Galvanized steel 6 Concrete tile 9 ABS

SCREEN OR PERFORATION OPENINGS ARE: 5 Gauzed wrapped 8 Saw cut 11 None (open hole)
 1 Continuous slot 3 Mill slot 6 Wire wrapped 9 Drilled holes
 2 Louvered shutter 4 Key punched 7 Torch cut 10 Other (specify) _____

SCREEN-PERFORATED INTERVALS: From 1.07 ft. to 1.17 ft. From _____ ft. to _____ ft.
 From _____ ft. to _____ ft. From _____ ft. to _____ ft.
 GRAVEL PACK INTERVALS: From 5.2 ft. to 1.17 ft. From _____ ft. to _____ ft.
 From _____ ft. to _____ ft. From _____ ft. to _____ ft.

6 GROUT MATERIAL: 1 Neat cement 2 Cement grout 3 Bentonite 4 Other _____
 Grout intervals: From 0 ft. to 5.2 ft., From _____ ft. to _____ ft., From _____ ft. to _____ ft.

What is the nearest source of possible contamination:
 1 Septic tank 4 Lateral lines 7 Pit privy 11 Livestock pens 14 Abandoned water well
 2 Sewer lines 5 Cess pool 8 Sewage lagoon 12 Fuel storage 15 Oil well/Gas well
 3 Watertight sewer lines 6 Seepage pit 9 Feedyard 13 Fertilizer storage 16 Other (specify below)
 9 Insecticide storage

Direction from well? N.A. in Pasture How many feet?

FROM	TO	LITHOLOGIC LOG	FROM	TO	PLUGGING INTERVALS
0	3	Top soil			
3	24	Sandy clay			
24	41	Sand & Gravel (loose)			
41	55	Sand - layers of Sand Rock			
55	61	Sand & Gravel			
61	64	Rock			
64	90	Sand layers of clay			
90	91	Rock			
91	116	Sand & Gravel			
116	117	Shale			

7 CONTRACTOR'S OR LANDOWNER'S CERTIFICATION: This water well was (1) constructed (2) reconstructed, or (3) plugged under my jurisdiction and was completed on (mo/day/year) 9-6-91 and this record is true to the best of my knowledge and belief. Kansas Water Well Contractor's License No. 184 This Water Well Record was completed on (mo/day/yr) 9-10-91 under the business name of Schenck & Sons Drilling Inc by (signature) Walt Schenck