


USE TYPEWRITER OR BALL POINT PEN-PRESS FIRMLY, PRINT CLEARLY.

BFD

WATER WELL RECORD
KSA 82a-1201-1215

Kansas Department of Health and Environment-Division of Environment
(Water well Contractors)
Topeka, Kansas 66620

1. Location of well:		County SHERMAN	Fraction SE 1/4 NW 1/4 NW 1/4	Section number 4	Township number T 10	Range number S R 41 EW
2. Distance and direction from nearest town or city: RULETON			3. Owner of well: DEANNA ALDERMAN			
Street address of well location if in city: 8 S 1W 14 S 14 E			R.R. or street: RFD 3			
4. Locate with "X" in section below:			City, state, zip code: Goodland Kansas			
<div style="text-align: center;"> </div>			Sketch map:			
5. Type and color of material			From	To	6. Bore hole dia. 26 in. Completion date Well depth 248 ft. 10-7-75	
M GRAVEL, SANDY CLAY, SANDSTONE			110	154	7. <input type="checkbox"/> Cable tool <input type="checkbox"/> Rotary <input type="checkbox"/> Driven <input type="checkbox"/> Dug <input type="checkbox"/> Hollow rod <input type="checkbox"/> Jetted <input type="checkbox"/> Bored <input checked="" type="checkbox"/> Reverse rotary	
SANDY CLAY, SANDSTONE			154	166	8. Use: <input type="checkbox"/> Domestic <input type="checkbox"/> Public supply <input type="checkbox"/> Industry <input checked="" type="checkbox"/> Irrigation <input type="checkbox"/> Air conditioning <input type="checkbox"/> Stock <input type="checkbox"/> Lawn <input type="checkbox"/> Oil field water <input type="checkbox"/> Other	
SANDY CLAY			166	171	9. Casing: Material Steel Height: Above or below Threaded <input type="checkbox"/> Welded <input checked="" type="checkbox"/> Surface 12 in. RMP <input type="checkbox"/> PVC <input type="checkbox"/> Weight 36 lbs./ft. Dia. 1 1/2 in. to 178 ft. depth Wall Thickness: inches or Dia. <input type="checkbox"/> in. to <input type="checkbox"/> ft. depth gage No. 217	
FINE SAND, SANDY CLAY, SANDSTONE			171	191	10. Screen: Manufacturer's name W. A. Brown	
M GRAVEL SANDY CLAY			191	199	Type LUGER Dia. 16	
FINE SAND, M GRAVEL, SANDSTONE			199	206	Slot/gauze 18-7 Length 70	
FINE SAND, SANDY CLAY			206	239	Set between 178 ft. and 240 ft. ft. and _____ ft.	
M GRAVEL SANDY CLAY, SANDSTONE			239	245	Gravel pack? Yes Size range of material 1/4-3/8	
M GRAVEL SANDY CLAY, SHALE			245	248	11. Static water level: _____ mo./day/yr. 112 ft. below land surface Date 10-9-75	
BROCK 248'					12. Pumping level below land surfaces: 230 ft. after 14 hrs. pumping 650 g.p.m. _____ ft. after _____ hrs. pumping _____ g.p.m. Estimated maximum yield 700 g.p.m.	
					13. Water sample submitted: _____ mo./day/yr. <input type="checkbox"/> Yes <input checked="" type="checkbox"/> No Date _____	
					14. Well head completion: <input type="checkbox"/> Pitless adapter _____ inches above grade	
					15. Well grouted? Yes With: <input type="checkbox"/> Neat cement <input type="checkbox"/> Bentonite <input checked="" type="checkbox"/> Concrete Depth: From 0 ft. to 10 ft.	
					16. Nearest source of possible contamination: ft. 1300 Direction West Type Cesspool Well disinfected upon completion? <input type="checkbox"/> Yes <input checked="" type="checkbox"/> No	
					17. Pump: _____ Not installed Manufacturer's name Western Land Rollen Model number 6M HP 25 Volts 440 Length of drop pipe 235 ft. capacity 200 g.p.m. Type: <input type="checkbox"/> Submersible <input checked="" type="checkbox"/> Turbine <input type="checkbox"/> Jet <input type="checkbox"/> Reciprocating <input type="checkbox"/> Centrifugal <input type="checkbox"/> Other	
18. Elevation:	19. Remarks:		20. Water well contractor's certification:			
Topography: <input type="checkbox"/> Hill <input type="checkbox"/> Slope <input checked="" type="checkbox"/> Upland <input type="checkbox"/> Valley	3453 (TOPO)		This well was drilled under my jurisdiction and this report is true to the best of my knowledge and belief. St H Duffing Co Inc 166 Business name _____ License No. _____ Address Goodland Kansas Signed Paul Clifford Date 10-5-75 Authorized representative			

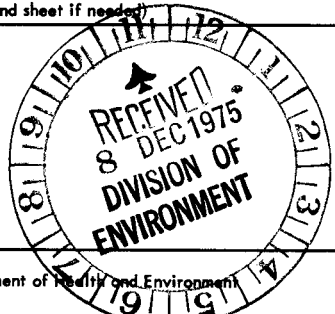

T 10 R 41 S 14 E NW 1/4