

USE TYPEWRITER OR BALL POINT PEN—PRESS FIRMLY, PRINT CLEARLY.

T R EW sec 1/4 1/4 1/4 No.


WATER WELL RECORD  
KSA 82a-1201-1215

Kansas State Dept. Of Health  
(Water Well Contractors)  
Forbes-Bldg. 740  
Topeka, Kansas 66620

*B3A*

1 Location of well: County Sheridan Township name NE McPherson Fraction NE 1/4 NW 1/4 Section number 8 Town number 10 Range number 41

Distance and direction from nearest town or city: Goodland Street address of well location if in city: 95 10 1/2 W  
3 Owner of well: MAX ALDERMAN Address: Goodland Kansas

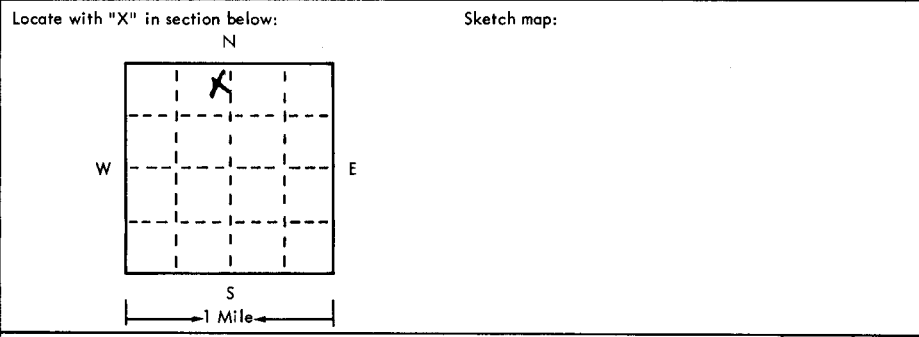

4 Well depth: 285 ft. Date of completion: 5-10-75  
Well diameter 8 in.  
5  Cable tool  Rotary  Driven  Dug  
 Hollow rod  Jetted  Bored  Reverse rotary  
6 Use:  Domestic  Public supply  Industry  
 Irrigation  Air conditioning  Commercial  
 Test well  \_\_\_\_\_  
7 Casing: Material Plastic Height: above/below  
Threaded  Welded  Surface 12 in.  
Diam. \_\_\_\_\_ Weight \_\_\_\_\_ lbs./ft. \_\_\_\_\_  
4 in. to 265 ft. depth Drive shoe?  Yes  No  
\_\_\_\_\_ in. to \_\_\_\_\_ ft. depth!

2	Type and color of material	From	To
	GRAVEL	89	98
	CLAY, FINE SAND, SANDSTONE	98	131
	GRAVEL, SANDY CLAY	131	140
	FINE SAND, GRAVEL, SANDSTONE	140	177
	FINE SAND, GRAVEL, SANDY CLAY	177	197
	GRAVEL, SANDY CLAY	197	232
	CLAY	232	233
	GRAVEL, TRACC CLAY	233	241
	GRAVEL	241	249
	CLAY	249	250
	GRAVEL	250	254
	GRAVEL, SANDSTONE	254	262
	GRAVEL	262	267
	CLAY, GRAVEL, SANDSTONE	267	285
	<u>BRICK ?</u>		
	(use a second sheet if needed)		

8 Screen: Manufacturer Jess & Lowell  
Type LUPER Dia. 4"  
Slot/gauze 1/8 - 200 Length \_\_\_\_\_  
Set between 265 ft. and 285 ft. \_\_\_\_\_  
Fittings: Gravel pack  Yes  No Size range of material 1/4  
9 Static water level: 89 ft. below land surface Date 5-10-75  
10 Pumping level below land surfaces:  
130 ft. after 5 hrs. pumping 15 g.p.m.  
\_\_\_\_\_ ft. after \_\_\_\_\_ hrs. pumping \_\_\_\_\_ g.p.m.  
Estimated maximum yield 15 g.p.m.  
11 Water sample submitted:  
 Yes  No Date \_\_\_\_\_  
12 Well head completion:  
 Pitless adapter  Inches above grade  
13 Well grouted?  Yes  No  
 Neat cement  Bentonite  \_\_\_\_\_  
Depth: From 0 ft. to 10 ft.  
14 Nearest source of possible contamination:  
ft. \_\_\_\_\_ Direction \_\_\_\_\_ Type NENE  
Well disinfected upon completion?  Yes  No  
15 Pump:  Not installed  
Manufacturer's name \_\_\_\_\_  
Model number \_\_\_\_\_ HP \_\_\_\_\_ Volts \_\_\_\_\_  
Length of drop pipe \_\_\_\_\_ ft. capacity \_\_\_\_\_ g.m.p.  
Type:  
 Submersible  Turbine  
 Jet  Reciprocating  
 Centrifugal  Other

16 Remarks: elevation 3852 (TUPO)

Topography:  
 Hill  
 Slope  
 Upland  
 Valley

17 Water well contractor's certification:  
This well was drilled under my jurisdiction and this report is true to the best of my knowledge and belief.  
L.H. Dunnington Inc. 166  
Business name \_\_\_\_\_ License No. \_\_\_\_\_  
Address Goodland Kan  
Signed Bill Dunnington Date 5-19-75  
Authorized representative