

USE TYPEWRITER OR BALL POINT PEN-PRESS FIRMLY, PRINT CLEARLY.


WATER WELL RECORD  
KSA 82a-1201-1215

Kansas Department of Health and Environment-Division of Environment  
(Water well Contractors)  
Topeka, Kansas 66620

ADD

1. Location of well: County SHERMAN Fraction SE 1/4 SE 1/4 NW 1/4 Section number 8 Township number T 10 Range number S R 41 20

2. Distance and direction from nearest town or city: Goodland  
Street address of well location if in city: 9W 8 1/2 S 2W 1/2 S  
3. Owner of well: MAX ALDERMAN  
R.R. or street: RR 3 BOX 83  
City, state, zip code: Goodland Kansas

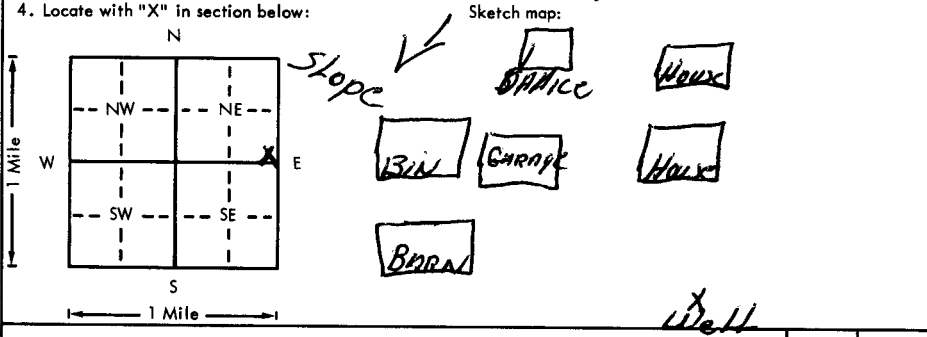


6. Bore hole dia. 8 in. Completion date 9-15-77  
Well depth 188 ft.  
7.  Cable tool  Rotary  Driven  Dug  
 Hollow rod  Jetted  Bored  Reverse rotary  
8. Use:  Domestic  Public supply  Industry  
 Irrigation  Air conditioning  Stock  
 Lawn  Oil field water  Other  
9. Casing: Material Plastic Height: Above or below  
Threaded  Welded  Surface 12 in.  
RMP  PVC  Weight          lbs./ft.  
Dia. 4 in. to 164 ft. depth Wall Thickness: inches or  
Dia.          in. to          ft. depth Gauge No. 1237

5. Type and color of material	From	To
<u>FINE SAND SANDY CLAY</u>	<u>68</u>	<u>76</u>
<u>M GRAVEL</u>	<u>76</u>	<u>79</u>
<u>M GRAVEL SANDY CLAY</u>	<u>79</u>	<u>84</u>
<u>FINE SAND SANDY CLAY</u>	<u>84</u>	<u>106</u>
<u>M GRAVEL SANDSTONE</u>	<u>106</u>	<u>111</u>
<u>M GRAVEL SANDY CLAY</u>	<u>111</u>	<u>137</u>
<u>M GRAVEL SANDSTONE</u>	<u>137</u>	<u>140</u>
<u>FINE SAND SANDY CLAY</u>	<u>140</u>	<u>151</u>
<u>M GRAVEL SANDSTONE</u>	<u>151</u>	<u>159</u>
<u>M GRAVEL SANDY CLAY</u>	<u>159</u>	<u>183</u>
<u>Ochrc</u>	<u>183</u>	<u>188</u>

10. Screen: Manufacturer's name Jess & Lowell  
Type louver Dia. 5  
Slot/gauze 1/8 - 258 Length 24  
Set between 167 ft. and 188 ft.  
ft. and          ft.  
Gravel pack? yes Size range of material 1/8  
11. Static water level: 74 ft. below land surface Date 9-7-77 mo./day/yr.  
12. Pumping level below land surfaces:  
125 ft. after 5 hrs. pumping 15 g.p.m.  
         ft. after          hrs. pumping          g.p.m.  
Estimated maximum yield 50 g.p.m.  
13. Water sample submitted:          mo./day/yr.  
 Yes  No Date           
14. Well head completion:  
 Pitless adapter 12 Inches above grade  
15. Well grouted? yes  
With:  Neat cement  Bentonite  Concrete  
Depth: From 5 ft. to 15 ft.  
16. Nearest source of possible contamination:  
ft. 200 Direction NW Type BARN  
Well disinfected upon completion?  Yes  No  
17. Pump:  Not installed  
Manufacturer's name Red Jacket  
Model number 15 BC HP 1 Volts 230  
Length of drop pipe 121 ft. capacity 15 g.p.m.  
Type:  
 Submersible  Turbine  
 Jet  Reciprocating  
 Centrifugal  Other

18. Elevation: 3830 (TOP)  
19. Remarks:           
Topography:  
 Hill  
 Slope  
 Upland  
 Valley

20. Water well contractor's certification:  
This well was drilled under my jurisdiction and this report is true to the best of my knowledge and belief.  
St H Dulling Co Inc 166  
Business name Goodland Kansas License No.           
Address           
Signed Bill Clifford Date 9-16-77  
Authorized representative

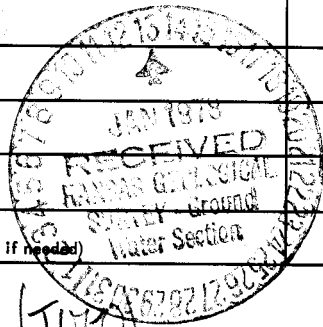

T  
R  
E  
10  
41  
8  
SE  
SE  
NE  
1/4  
1/4  
1/4