

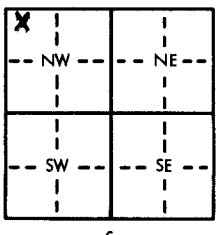
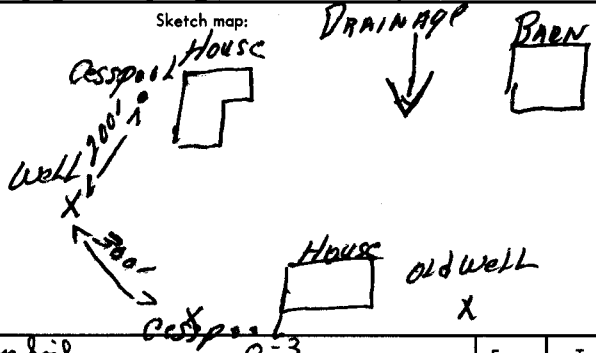
Sent 12/5/77

USE TYPEWRITER OR BALL POINT PEN-PRESS FIRMLY, PRINT CLEARLY.

WATER WELL RECORD
KSA 82a-1201-1215

Kansas Department of Health and Environment-Division of Environment
(Water well Contractors)
Topeka, Kansas 66620

BBB

1. Location of well: County: <u>SHERMAN</u>		Fraction: <u>NW 1/4 NW 1/4 NW 1/4</u>		Section number: <u>12</u>		Township number: <u>T 10 S R 41 NW</u>		Range number: <u>41 NW</u>	
2. Distance and direction from nearest town or city: <u>Goodland</u> Street address of well location if in city: <u>7W 9 S</u>				3. Owner of well: <u>JIM MOORE</u> R.R. or street: <u>RFD 1</u> City, state, zip code: <u>Goodland Kansas 67735</u>					
4. Locate with "X" in section below:  1 Mile N W E S 1 Mile				Sketch map: 		6. Bore hole dia. <u>8</u> in. Completion date: <u>4-12-76</u> Well depth <u>177</u> ft.			
5. Type and color of material				From		To		7. <input checked="" type="checkbox"/> Cable tool <input checked="" type="checkbox"/> Rotary <input type="checkbox"/> Driven <input type="checkbox"/> Dug <input type="checkbox"/> Hollow rod <input type="checkbox"/> Jetted <input type="checkbox"/> Bored <input type="checkbox"/> Reverse rotary	
<u>M Gravel, Sandstone</u>				<u>69</u>		<u>76</u>		8. Use: <input checked="" type="checkbox"/> Domestic <input type="checkbox"/> Public supply <input type="checkbox"/> Industry <input type="checkbox"/> Irrigation <input type="checkbox"/> Air conditioning <input type="checkbox"/> Stock <input type="checkbox"/> Lawn <input type="checkbox"/> Oil field water <input type="checkbox"/> Other	
<u>M Gravel, Sandy Clay</u>				<u>76</u>		<u>98</u>		9. Casing: Material <u>Plastic</u> Height: Above or below Threaded <input type="checkbox"/> Welded <input type="checkbox"/> Surface <u>12</u> in. RMP <input type="checkbox"/> PVC <input checked="" type="checkbox"/> Weight _____ lbs./ft. Dia. <u>4.5</u> in. to <u>152</u> ft. depth Wall Thickness: inches or Dia. _____ in. to _____ ft. depth gage No. <u>200237</u>	
<u>Sandy Clay, Sandstone</u>				<u>98</u>		<u>104</u>		10. Screen: Manufacturer's name _____ <u>JESSY LOWELL</u> Type <u>LUGER</u> Dia. <u>5</u> Slot/gauze <u>1/8 20025</u> Length <u>20</u> Set between <u>157</u> ft. and <u>177</u> ft. _____ ft. and _____ ft. Gravel pack? <u>Yes</u> Size range of material <u>1/8</u>	
<u>Gravel, Sandy Clay, Sandstone</u>				<u>104</u>		<u>120</u>		11. Static water level: _____ mo./day/yr. <u>73</u> ft. below land surface Date <u>12-29-75</u>	
<u>Sandy Clay, Sandstone</u>				<u>120</u>		<u>127</u>		12. Pumping level below land surfaces: <u>100</u> ft. after <u>2</u> hrs. pumping <u>20</u> g.p.m. _____ ft. after _____ hrs. pumping _____ g.p.m. Estimated maximum yield <u>50</u> g.p.m.	
<u>M Gravel Sandstone</u>				<u>127</u>		<u>133</u>		13. Water sample submitted: _____ mo./day/yr. Yes <input checked="" type="checkbox"/> No <input type="checkbox"/> Date _____	
<u>Clay</u>				<u>133</u>		<u>136</u>		14. Well head completion: <input checked="" type="checkbox"/> Pitless adapter <u>12</u> Inches above grade	
<u>M Gravel, Sandy Clay</u>				<u>136</u>		<u>146</u>		15. Well grouted? <u>Yes</u> With: <input checked="" type="checkbox"/> Neat cement <input type="checkbox"/> Bentonite <input checked="" type="checkbox"/> Concrete Depth: From <u>5</u> ft. to <u>15</u> ft.	
<u>Clay</u>				<u>146</u>		<u>153</u>		16. Nearest source of possible contamination: fr. <u>200</u> Direction <u>NE</u> Type <u>Cesspool</u> Well disinfected upon completion? <input checked="" type="checkbox"/> Yes <input type="checkbox"/> No	
<u>M Gravel Sandy Clay</u>				<u>153</u>		<u>173</u>		17. Pump: _____ Not installed Manufacturer's name <u>Red Jacket</u> Model number <u>11CC</u> HP <u>1 1/2</u> Volts <u>220</u> Length of drop pipe <u>157</u> ft. capacity <u>20</u> g.p.m. Type: <input checked="" type="checkbox"/> Submersible _____ Turbine _____ Jet _____ Reciprocating _____ Centrifugal _____ Other	
<u>Ochre</u>				<u>173</u>		<u>177</u>		20. Water well contractor's certification: This well was drilled under my jurisdiction and this report is true to the best of my knowledge and belief. <u>S & H Drilling Co Inc 166</u> Business name _____ License No. _____ Address <u>Goodland Kansas</u> Signed <u>Bill Clifford</u> Date <u>4-12-76</u> Authorized representative	
18. Elevation: Topography: ____ Hill ____ Slope <input checked="" type="checkbox"/> Upland ____ Valley				19. Remarks: <u>3782</u> <u>BROCK 173'</u>					

10 41 NW
12
Sec
1/4 NW NW NW
1/4 NW NW NW
1/4 NW NW NW