


1 LOCATION OF WATER WELL: Fraction NE 1/4 NW 1/4 NW 1/4 Section Number 29 Township Number T 10 S Range Number R 41 EW

Distance and direction from nearest town or city street address of well if located within city?  
 8 mi. S, 3 mi. W, 4 1/4 mi. S., 1/4 mi. East of Ruleton

2 WATER WELL OWNER: John Golden  
 RR#, St. Address, Box #: 110 E. 11th Board of Agriculture, Division of Water Resources  
 City, State, ZIP Code: Goodland, Ks. 67735 Application Number:

3 LOCATE WELL'S LOCATION WITH AN "X" IN SECTION BOX:

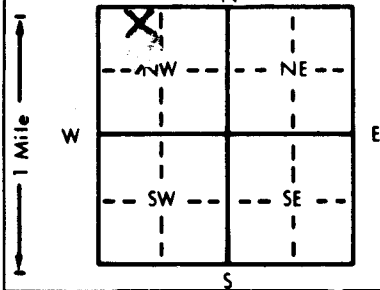

4 DEPTH OF COMPLETED WELL: 155 ft. ELEVATION:  
 Depth(s) Groundwater Encountered 1. .... ft. 2. .... ft. 3. .... ft.  
 WELL'S STATIC WATER LEVEL: 56 ft. below land surface measured on mo/day/yr  
 Pump test data: Well water was .... ft. after .... hours pumping .... gpm  
 Est. Yield .... gpm: Well water was .... ft. after .... hours pumping .... gpm  
 Bore Hole Diameter: 8 in. to 155 ft., and .... in. to .... ft.  
 WELL WATER TO BE USED AS:  
 1 Domestic 3 Feedlot 6 Oil field water supply 9 Dewatering 12 Other (Specify below)  
 2 Irrigation 4 Industrial 7 Lawn and garden only 10 Monitoring well  
 Was a chemical/bacteriological sample submitted to Department? Yes.....No..X.....; If yes, mo/day/yr sample was sub-  
 mitted Water Well Disinfected? Yes No X

5 TYPE OF BLANK CASING USED:  
 1 Steel 3 RMP (SR) 5 Wrought iron 8 Concrete tile CASING JOINTS: Glued ..X.. Clamped ..  
 2 PVC 4 ABS 6 Asbestos-Cement 9 Other (specify below) Welded ..  
 7 Fiberglass Threaded ..

Blank casing diameter: 4.5 in. to 11.5 ft., Dia. .... in. to .... ft., Dia. .... in. to .... ft.  
 Casing height above land surface: 18 in., weight 2.38 lbs./ft. Wall thickness or gauge No. 248

TYPE OF SCREEN OR PERFORATION MATERIAL:  
 1 Steel 3 Stainless steel 5 Fiberglass 7 PVC 10 Asbestos-cement  
 2 Brass 4 Galvanized steel 6 Concrete tile 8 RMP (SR) 11 Other (specify) ..  
 12 None used (open hole)

SCREEN OR PERFORATION OPENINGS ARE:  
 1 Continuous slot 3 Mill slot 5 Gauzed wrapped 8 Saw cut 11 None (open hole)  
 2 Louvered shutter 4 Key punched 6 Wire wrapped 9 Drilled holes  
 7 Torch cut 10 Other (specify) ..

SCREEN-PERFORATED INTERVALS: From 115 ft. to 155 ft., From .... ft. to .... ft.  
 GRAVEL PACK INTERVALS: From 20 ft. to 155 ft., From .... ft. to .... ft.

6 GROUT MATERIAL: 1 Neat cement 2 Cement grout 3 Bentonite 4 Other  
 Grout Intervals: From 0 ft. to 20 ft., From .... ft. to .... ft., From .... ft. to .... ft.

What is the nearest source of possible contamination:  
 1 Septic tank 4 Lateral lines 7 Pit privy 10 Livestock pens 14 Abandoned water well  
 2 Sewer lines 5 Cess pool 8 Sewage lagoon 11 Fuel storage 15 Oil well/Gas well  
 3 Watertight sewer lines 6 Seepage pit 9 Feedyard 12 Fertilizer storage 16 Other (specify below)  
 13 Insecticide storage

Direction from well? Northwest How many feet? 25'

FROM	TO	LITHOLOGIC LOG	FROM	TO	PLUGGING INTERVALS
0	2	Surface	147	148	Sand
2	16	Loess	148	151	Clay
16	17	Hard Layer	151	152	Sand
17	32	Clay & Sand	152	155	Ochre
32	47	Sand & Gravel			
47	62	Red Clay			
62	65	Sand			
65	66	Caliche			
66	80	Clay, Caliche & Sand Strks.			
80	86	Med. To Fine Sand/Clay Strks.			
86	94	Clay & Caliche			
94	126	Med. Sand & Gravel/Clay Lyrs.			
126	130	Clay			
130	141	Sand & Gravel/Clay Strks.			
141	147	Clay			

7 CONTRACTOR'S OR LANDOWNER'S CERTIFICATION: This water well was (1) constructed, (2) reconstructed, or (3) plugged under my jurisdiction and was completed on (mo/day/year) 11-4-93 and this record is true to the best of my knowledge and belief. Kansas Water Well Contractor's License No. 554 This Water Well Record was completed on (mo/day/yr) 11-5-93 under the business name of Woofter Pump & Well, Inc. by (signature) Guy C. Woofter