


1 LOCATION OF WATER WELL: County: SHERMAN Fraction: NE 1/4 NE 1/4 SW 1/4 Section Number: 36 Township Number: T 10 S Range Number: R 41 E

Distance and direction from nearest town or city street address of well if located within city?

1/2 South, 1/2 East

2 WATER WELL OWNER: LAVERN NELSON
 RR#, St. Address, Box #: RR # 3
 City, State, ZIP Code: Galiton KANSAS
 Board of Agriculture, Division of Water Resources
 Application Number:

3 LOCATE WELL'S LOCATION WITH AN "X" IN SECTION BOX: 143 ft. ELEVATION:

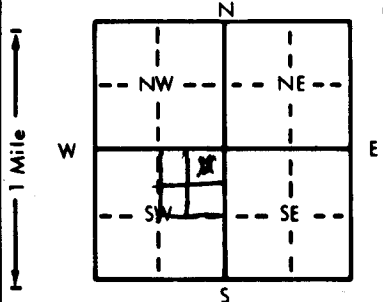

4 DEPTH OF COMPLETED WELL: 143 ft. ELEVATION: 85 ft.
 Depth(s) Groundwater Encountered 1. 85 ft. 2. _____ ft. 3. _____ ft.
 WELL'S STATIC WATER LEVEL _____ ft. below land surface measured on mo/day/yr _____
 Pump test data: Well water was _____ ft. after _____ hours pumping _____ gpm
 Est. Yield _____ gpm: Well water was _____ ft. after _____ hours pumping _____ gpm
 Bore Hole Diameter: 6" in. to _____ ft., and _____ in. to _____ ft.
 WELL WATER TO BE USED AS:
 1 Domestic 3 Feedlot 6 Oil field water supply 9 Dewatering 12 Other (Specify below)
 2 Irrigation 4 Industrial 7 Lawn and garden only 10 Monitoring well
 Was a chemical/bacteriological sample submitted to Department? Yes _____ No X; If yes, mo/day/yr sample was submitted _____
 Water Well Disinfected? Yes No

5 TYPE OF BLANK CASING USED: None
 1 Steel 3 RMP (SR) 5 Wrought iron 8 Concrete tile CASING JOINTS: Glued _____ Clamped _____
 2 PVC 4 ABS 6 Asbestos-Cement 9 Other (specify below) Welded _____
 7 Fiberglass Threaded _____
 Blank casing diameter _____ in. to _____ ft., Dia _____ in. to _____ ft., Dia _____ in. to _____ ft.
 Casing height above land surface _____ in., weight _____ lbs./ft. Wall thickness or gauge No. _____
 TYPE OF SCREEN OR PERFORATION MATERIAL: None
 1 Steel 3 Stainless steel 5 Fiberglass 7 PVC 8 RMP (SR) 10 Asbestos-cement
 2 Brass 4 Galvanized steel 6 Concrete tile 9 ABS 11 Other (specify) _____
 12 None used (open hole)
 SCREEN OR PERFORATION OPENINGS ARE:
 1 Continuous slot 3 Mill slot 5 Gauzed wrapped 8 Saw cut 11 None (open hole)
 2 Louvered shutter 4 Key punched 6 Wire wrapped 9 Drilled holes
 7 Torch cut 10 Other (specify) N.A.
 SCREEN-PERFORATED INTERVALS: From _____ ft. to _____ ft., From _____ ft. to _____ ft.
 GRAVEL PACK INTERVALS: None From _____ ft. to _____ ft., From _____ ft. to _____ ft.

TEST HOLE
 DEP. PROSPECT

6 GROUT MATERIAL: Neat cement 2 Cement grout 3 Bentonite 4 Other: SAND + GRAVEL CUTTINGS
 Grout Intervals: From 0 ft. to 10 ft., From _____ ft. to _____ ft., From 10 ft. to 140 ft.
 What is the nearest source of possible contamination: None visible
 1 Septic tank 4 Lateral lines 7 Pit privy 10 Livestock pens 14 Abandoned water well
 2 Sewer lines 5 Cess pool 8 Sewage lagoon 11 Fuel storage 15 Oil well/Gas well
 3 Watertight sewer lines 6 Seepage pit 9 Feedyard 12 Fertilizer storage 16 Other (specify below)
 13 Insecticide storage NONE
 Direction from well? _____ How many feet? _____

FROM	TO	LITHOLOGIC LOG	FROM	TO	PLUGGING INTERVALS
0	20	Clay			
20	55	SAND Stone SAND + GRAVEL			
55	100	SAND + GRAVEL LAYERED CLAY			
100	105	White Clay			
105	120	Loose SAND + GRAVEL			
120	125	White clay + SAND Stone			
125	140	1/4 to 3/8 loose GRAVEL			
140	143	Shale			

Plugged back with
 GRAVEL CUTTINGS
 AND SURFACE CLAY
 MATERIALS +
 Cement Plug

7 CONTRACTOR'S OR LANDOWNER'S CERTIFICATION: This water well was (1) constructed, (2) reconstructed, or (3) plugged under my jurisdiction and was completed on (mo/day/year) 6-13-91 and this record is true to the best of my knowledge and belief. Kansas Water Well Contractor's License No. 484 This Water Well Record was completed on (mo/day/yr) _____ under the business name of SCHAAL DRILLING by (signature) Robert Schaal