

USE TYPEWRITER OR BALL POINT PEN-PRESS FIRMLY, PRINT CLEARLY.

WATER WELL RECORD
KSA 82a-1201-1215

Kansas Department of Health and Environment-Division of Environment
(Water well Contractors)
Topeka, Kansas 66620

1. Location of well: County **SHEMAN** Fraction **NE 1/4 NE 1/4 SE 1/4** Section number **2** Township number **T 10 S** Range number **R 42 E (N)**

2. Distance and direction from nearest town or city: _____
Street address of well location if in city: _____
3. Owner of well: **Gene Hall**
R.R. or street: **KANORADO, KANSAS 67741**
City, state, zip code: _____

4. Locate with "X" in section below: Sketch map:

N
W E
S

6. Bore hole dia. **24** in. Completion date **9-1-76**
Well depth **283** ft.

7. Cable tool Rotary Driven Dug
 Hollow rod Jetted Bored Reverse rotary

8. Use: Domestic Public supply Industry
 Irrigation Air conditioning Stock
 Lawn Oil field water Other

9. Casing: Material **Steel** Height: Above or below
Threaded Welded Surface _____ in.
RMP PVC Weight **33** lbs./ft.
Dia. **8** in. to **283** ft. depth Wall Thickness: inches or
Dia. _____ in. to _____ ft. depth gage No. **188**

5. Type and color of material	From	To
Top Soil & clay	0	139
Gravel	139	213
Sand	213	224
Gravel	224	233
Clay	233	238
Gravel	238	239
Clay	239	243
Gravel	243	252
Sandstone	252	255
Gravel	255	264
Sandstone	264	266
Soapstone	280	282
Shale	282	286
(Use a second sheet if needed)		

10. Screen: Manufacturer's name **W.B. Brown**

Type **Mill salt** Dia. **16**
Slot/gauze **1/8** Length **40**
Set between **160** ft. and **282** ft.
_____ ft. and _____ ft.
Gravel pack? Size range of material **1/2"**

11. Static water level: _____ mo./day/yr.
130 ft. below land surface Date **8-20-76**

12. Pumping level below land surfaces:
180 ft. after **8** hrs. pumping **800** g.p.m.
230 ft. after **16** hrs. pumping **1618** g.p.m.
Estimated maximum yield **1018** g.p.m.

13. Water sample submitted: _____ mo./day/yr.
Yes No Date _____

14. Well head completion:
 Pitless adapter _____ inches above grade

15. Well grouted?
With: Neat cement Bentonite Concrete
Depth: From **10** ft. to **8"** ABOVE


16. Nearest source of possible contamination:
ft. _____ Direction _____ Type _____
Well disinfected upon completion? Yes No

17. Pump: Not installed
Manufacturer's name **TAITAYE**
Model number **20 820 RHP** _____ Volts _____
Length of drop pipe **270** ft. capacity **1618** g.p.m.
Type: Submersible Turbine
 Jet Reciprocating
 Centrifugal Other

18. Elevation: _____
19. Remarks: **3930 (TOP)**

Topography:
 Hill
 Slope
 Upland
 Valley

20. Water well contractor's certification:
This well was drilled under my jurisdiction and this report is true to the best of my knowledge and belief.
Foust Supply Co Inc 144
Business name License No. _____
Address **Box 338 Goodland, Kansas**
Signed **Ralph P. Foust** Date **10-18-76**
Authorized representative

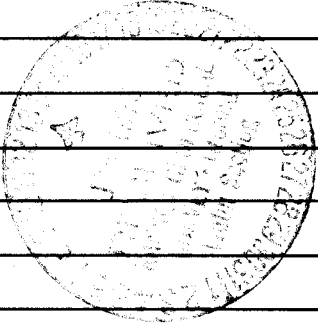

10420-2 SEP-NESE 1/4 1/4 1/4