

USE TYPEWRITER OR BALL POINT PEN-PRESS FIRMLY, PRINT CLEARLY.

DAB

WATER WELL RECORD
KSA 82a-1201-1215

Kansas Department of Health and Environment-Division of Environment
(Water well Contractors)
Topeka, Kansas 66620

NW

1. Location of well: County SHERMAN Fraction NE SE 1/4 Section number 8 Township number T 10 S Range number R 42 E

2. Distance and direction from nearest town or city: 95 1/2 W 3. Owner of well: Jim Livengood
Street address of well location if in city: KANORADO, KANS. R.R. or street: KANORADO, Kansas City, state, zip code: 67741

4. Locate with "X" in section below: Sketch map:


6. Bore hole dia. 24 in. Completion date 7-6-70
Well depth 282 ft.
7. Cable tool Rotary Driven Dug
 Hollow rod Jetted Bored Reverse rotary
8. Use: Domestic Public supply Industry
 Irrigation Air conditioning Stock
 Lawn Oil field water Other
9. Casing: Material Steel Height: Above or below
Threaded Welded Surface 8 in.
RMP PVC Weight 32 lbs./ft.
Dia. 8 in. to 282 ft. depth Wall Thickness: inches or
Dia. 8 in. to 282 ft. depth gage No. 188

5. Type and color of material	From	To
Top soil & clay	50	41
Gravel	141	153
Sand & sandstone	153	218
Sandstone & clay	218	252
Gravel	252	263
Clay	263	265
Gravel	265	268
Clay	268	280
Soapstone	280	295
Shale	295	

10. Screen: Manufacturer's name W.A. Brown
Type mill salt Dia. 16
Slot/gauze _____ Length 40
Set between 162 ft. and 282 ft.
_____ ft. and _____ ft.
Gravel pack? Size range of material 1/2"
11. Static water level: _____ mo./day/yr.
120 ft. below land surface Date 8-12-76
12. Pumping level below land surfaces:
180 ft. after 8 hrs. pumping 700 g.p.m.
280 ft. after 16 hrs. pumping 930 g.p.m.
Estimated maximum yield 930 g.p.m.
13. Water sample submitted: _____ mo./day/yr.
Yes No Date _____
14. Well head completion:
_____ Pitless adapter _____ Inches above grade
15. Well grouted?
With: Neat cement Bentonite _____ Concrete _____
Depth: From 10 ft. to 8" ft. Above
16. Nearest source of possible contamination:
ft. _____ Direction _____ Type _____
Well disinfected upon completion? _____ Yes _____ No
17. Pump: _____ Not installed
Manufacturer's name Johnston
Model number 480117 HP _____ Volts _____
Length of drop pipe 210 ft. capacity 930 g.p.m.
Type:
 Submersible Turbine
 Jet Reciprocating
 Centrifugal Other

18. Elevation: _____
19. Remarks: 3577 (TOPO)
Topography:
 Hill
 Slope
 Upland
 Valley

20. Water well contractor's certification:
This well was drilled under my jurisdiction and this report is true to the best of my knowledge and belief.
Trust Supply Co Inc License No. 144
Business name Trust Supply Co Inc
Address 298 Goodland Kansas
Signed Ralph E. ... Date 12-14-76
Authorized representative

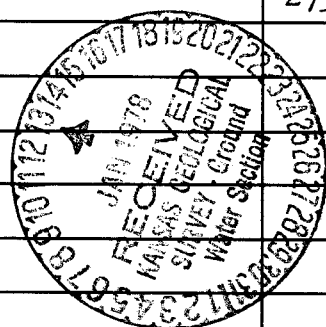

10 420 - 8 NW NE SE 1/4 1/4 1/4 1/4