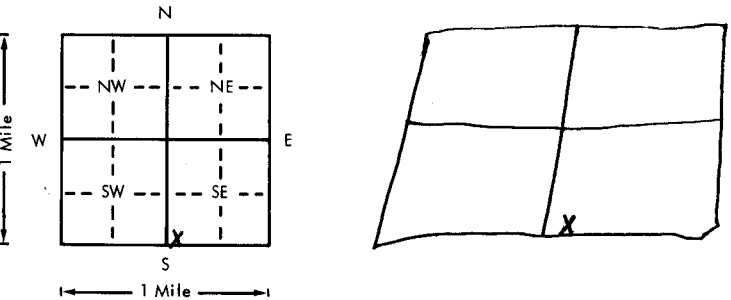


USE TYPEWRITER OR BALL POINT PEN-PRESS FIRMLY, PRINT CLEARLY.

WATER WELL RECORD  
KSA 82a-1201-1215

Kansas Department of Health and Environment-Division of Environment  
(Water well Contractors)  
Topeka, Kansas 66620

1. Location of well: County: <u>Sherman</u>		Fraction: <u>SW 1/4 SW 1/4 SE 1/4</u>		Section number: <u>14</u>	Township number: T <u>10</u>	Range number: S <u>42</u> E <u>W</u>
2. Distance and direction from nearest town or city: Street address of well location if in city: <u>11 South 2 1/2 East of Kanorado Ks.</u>				3. Owner of well: <u>Carl Denton</u> R.R. or street: <u>R. R. 3 Kanorado Ks.</u> City, state, zip code: <u>67735</u>		
4. Locate with "X" in section below: Sketch map: 				6. Bore hole dia. <u>4 1/2</u> in. Completion date <u>9-11-78</u> Well depth <u>197</u> ft.		
5. Type and color of material				7. <input checked="" type="checkbox"/> Cable tool <input checked="" type="checkbox"/> Rotary <input type="checkbox"/> Driven <input type="checkbox"/> Dug <input type="checkbox"/> Hollow rod <input type="checkbox"/> Jetted <input type="checkbox"/> Bored <input type="checkbox"/> Reverse rotary		
				8. Use: <input checked="" type="checkbox"/> Domestic <input type="checkbox"/> Public supply <input type="checkbox"/> Industry <input type="checkbox"/> Irrigation <input type="checkbox"/> Air conditioning <input type="checkbox"/> Stock <input type="checkbox"/> Lawn <input type="checkbox"/> Oil field water <input type="checkbox"/> Other		
From To				9. Casing: Material <u>Steel</u> Height: <u>Above</u> or below Threaded <input checked="" type="checkbox"/> Welded <input type="checkbox"/> Surface <u>12</u> in. RMP <input type="checkbox"/> PVC <input type="checkbox"/> Weight <u>16.8</u> lbs./ft. Dia. <u>4 1/2</u> in. to <u>178</u> ft. depth Wall Thickness: inches or Dia. <input type="checkbox"/> in. to <input type="checkbox"/> ft. depth Gauge No. <u>-117</u>		
				10. Screen: Manufacturer's name <u>DORRERS</u> Type <u>KEY PUNCH</u> Dia. <u>4 1/2</u> Slot/gauze <u>4/32</u> Length <u>20</u> Set between <u>178</u> ft. and <u>198</u> ft. ft. and <input type="checkbox"/> ft. Gravel pack? <input checked="" type="checkbox"/> Size range of material <u>1/8 X 3/8</u>		
Clay & Sandstone				0	112	11. Static water level: <u>112</u> ft. below land surface Date <u>9-11-78</u> mo./day/yr.
Gravel				112	121	
Sandy clay				121	142	12. Pumping level below land surfaces: <u>115</u> ft. after <u>8</u> hrs. pumping <u>10</u> g.p.m. <input type="checkbox"/> ft. after <input type="checkbox"/> hrs. pumping <input type="checkbox"/> g.p.m. Estimated maximum yield <u>15</u> g.p.m.
Gravel				142	148	
Sandy clay & Sandstone				148	169	13. Water sample submitted: <input type="checkbox"/> Yes <input checked="" type="checkbox"/> No Date _____ mo./day/yr.
Sand				169	175	
Sandy clay				175	178	14. Well head completion: <input checked="" type="checkbox"/> Pitless adapter <u>12</u> inches above grade
Gravel				178	186	
Soapstone				186	195	15. Well grouted? <input checked="" type="checkbox"/> With: <input checked="" type="checkbox"/> Neat cement <input type="checkbox"/> Bentonite <input type="checkbox"/> Concrete Depth: From <u>5</u> ft. to <u>15</u> ft.
Shale				195	197	
BROCK 186'				16. Nearest source of possible contamination: ft. _____ Direction _____ Type _____ Well disinfected upon completion? <input checked="" type="checkbox"/> Yes <input type="checkbox"/> No		
				17. Pump: <input checked="" type="checkbox"/> Not installed Manufacturer's name _____ Model number _____ HP _____ Volts _____ Length of drop pipe _____ ft. capacity _____ g.p.m. Type: <input type="checkbox"/> Submersible <input type="checkbox"/> Turbine <input type="checkbox"/> Jet <input type="checkbox"/> Reciprocating <input type="checkbox"/> Centrifugal <input type="checkbox"/> Other		
(Use a second sheet if needed)						
18. Elevation:		19. Remarks: <u>Farmer Run Concrete &amp; Pump</u> <u>Carl Denton</u>		20. Water well contractor's certification: This well was drilled under my jurisdiction and this report is true to the best of my knowledge and belief. <u>Loast Supply Co Inc</u> <u>149</u> Business name License No. Address <u>Box 338 Goodland KANS</u> Signed <u>Ralph E. [Signature]</u> Date <u>2-28-79</u> Authorized representative		
Topography: <input type="checkbox"/> Hill <input type="checkbox"/> Slope <input type="checkbox"/> Upland <input type="checkbox"/> Valley						

T 10 42 W E 14 SW SW SE  
R 42 W E 14 SW SW SE  
Sec 14