

GOODLAND 3NW

USE TYPEWRITER OR BALL POINT PEN-PRESS FIRMLY, PRINT CLEARLY.

T R EW sec 1/4 1/4 1/4 No.


WATER WELL RECORD
KSA 82a-1201-1215

Kansas State Dept. Of Health
(Water Well Contractors)
Forbes-Bldg. 740
Topeka, Kansas 66620

SW 1/4 BAC

1 Location of well: County SHERMAN Township name McPHERSON Fraction SW 1/4 Section number 15 Town number 10 Range number 42

Distance and direction from nearest town or city: 9 miles south of KANORADO 1/2 EAST KANSAS 3 Owner of well: EUGENE HALL
Street address of well location if in city: KANORADO, KANSAS Address: KANORADO, KANSAS

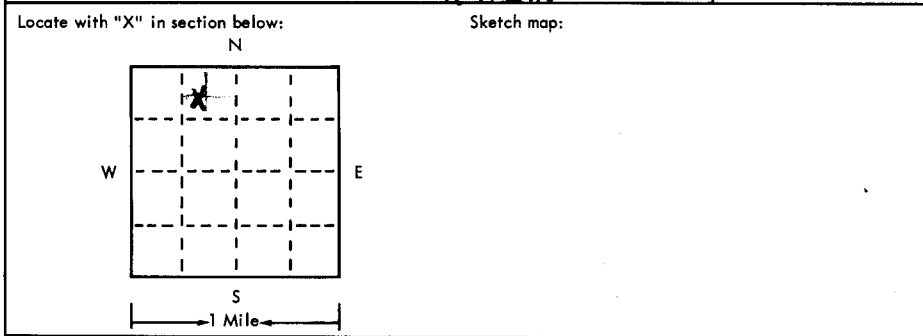

4 Well depth: 275 ft. Date of completion 8-22-50
Well diameter 16 in.

5 Cable tool Rotary Driven Dug
 Hollow rod Jetted Bored Reverse rotary

6 Use: Domestic Public supply Industry
 Irrigation Air conditioning Commercial
 Test well

7 Casing: Material Steel Height: above/below
Threaded Welded Surface 8 in.
Diam. 1 1/2 in. to 2 3/4 ft. depth; Weight 27 lbs./ft.
Drive shoe? Yes No

2	Type and color of material	From	To
	Gravel	125	130
	Clay	130	143
	Gravel	143	149
	Clay	149	191
	Gravel	191	198
	Sandstone	198	200
	Gravel	200	215
	Clay	215	242
	Gravel	242	244
	Clay	244	258
	Gravel	258	269
	Hard Sandstone	269	271
	Gravel	271	311
	Soapstone	311	313
	Shale	313	

(use a second sheet if needed)

8 Screen: Manufacturer W.A. Brown
Type Mill salt Dia. 1 1/2"
Slot/gauze 1/8" Length 120"
Set between 175 ft. and 275 ft.
Fittings: Gravel pack Yes No Size range of material 1/2"

9 Static water level: 105 ft. below land surface Date 8-1-75

10 Pumping level below land surfaces:
280 ft. after 8 hrs. pumping 290 g.p.m.
____ ft. after ____ hrs. pumping ____ g.p.m.
Estimated maximum yield 290 g.p.m.

11 Water sample submitted:
 Yes No Date _____

12 Well head completion:
 Pitless adapter Inches above grade

13 Well grouted? Yes No
 Neat cement Bentonite _____
Depth: From 2" ft. to 10 ft.

14 Nearest source of possible contamination:
ft. _____ Direction _____ Type _____
Well disinfected upon completion? Yes No

15 Pump: Not installed
Manufacturer's name TAIT A/C
Model number _____ HP _____ Volts _____
Length of drop pipe 280 ft. capacity 290 g.p.m.
Type:
 Submersible Turbine
 Jet Reciprocating
 Centrifugal Other

16 Remarks: elevation 3940 (TOP)

Topography:
 Hill
 Slope
 Upland
 Valley

17 Water well contractor's certification:
This well was drilled under my jurisdiction and this report is true to the best of my knowledge and belief.
FOUST Supply Co Inc 144
Business name _____ License No. _____
Address Box 338 Goodland Kan
Signed Archie Chapman Date 8-7-50
Authorized representative