

MR. SUNFLOWER NE

USE TYPEWRITER OR BALL POINT PEN-PRESS FIRMLY, PRINT CLEARLY.

T R EW sec 1/4 1/4 1/4 No.

WATER WELL RECORD
KSA 82a-1201-1215


Kansas State Dept. Of Health
(Water Well Contractors)
Forbes-Bldg. 740
Topeka, Kansas 66620

LE- DRD

1 Location of well: County SHERMAN Township name McPHERSON Fraction SE 1/4 Section number 17 Town number 10 Range number 42

Distance and direction from nearest town or city: 9 mile south of 3 Owner of well: EUGENE HALL

Street address of well location if in city: KANORADO 1/4 WEST Address: KANORADO, KANSAS

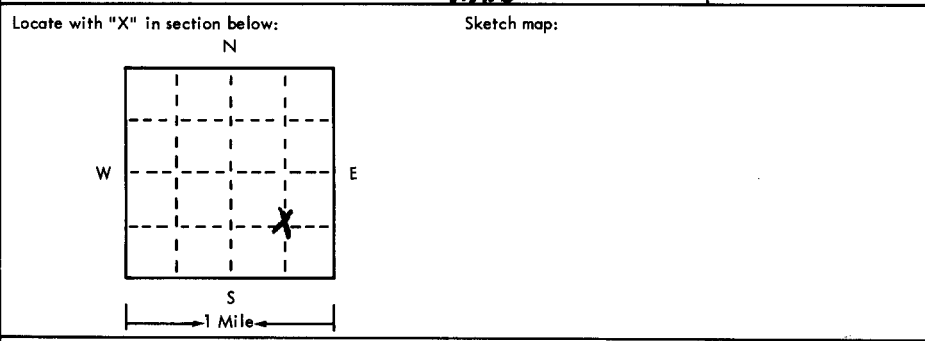

4 Well depth: 316 ft. Date of completion 9-3-75
Well diameter 16 in.

5 Cable tool Rotary Driven Dug
 Hollow rod Jetted Bored Reverse rotary

6 Use: Domestic Public supply Industry
 Irrigation Air conditioning Commercial
 Test well

7 Casing: Material Steel Height: above/below
Threaded Welded Surface 8 in.
Diam. 16 in. Weight 27 lbs./ft.
16 in. to 316 ft. depth Drive shoe? Yes No

2	Type and color of material	From	To
	Gravel	141	144
	Sandstone	144	164
	Clay	164	176
	Sandstone	176	183
	Gravel	183	203
	Clay	203	224
	Gravel	224	285
	Sandstone	285	286
	Gravel	286	292
	Soapstone	292	295
	Shale	295	
	<u>15KOCK 292'</u>		

8 Screen: Manufacturer WA. BROWN
Type MILLSAP Dia. 16
Slot/gauze 1/8 Length 140
Set between 176 ft. and 316 ft.
Fittings: Gravel pack Yes No Size range of material 1/2

9 Static water level: 125 ft. below land surface Date 8-1-75

10 Pumping level below land surfaces:
300 ft. after 8 hrs. pumping 1140 g.p.m.
____ ft. after ____ hrs. pumping ____ g.p.m.
Estimated maximum yield 1140 g.p.m.

11 Water sample submitted:
 Yes No Date _____

12 Well head completion:
 Pitless adapter Inches above grade

13 Well grouted? Yes No
 Neat cement Bentonite _____
Depth: From 8" to 10 ft.

14 Nearest source of possible contamination:
ft. _____ Direction _____ Type _____
Well disinfected upon completion? Yes No

15 Pump: Not installed
Manufacturer's name TAIT H&C
Model number _____ HP _____ Volts _____
Length of drop pipe 300 ft. capacity 1140 g.p.m.
Type:
 Submersible Turbine
 Jet Reciprocating
 Centrifugal Other

16 Remarks: elevation 3981 (TOPO)

Topography:
 Hill
 Slope
 Upland
 Valley

17 Water well contractor's certification:
This well was drilled under my jurisdiction and this report is true to the best of my knowledge and belief.

Business name _____ License No. _____
Address Boys Supply Co Inc 1544
Signed Boys Supply Co Inc Date 9-7-75
Authorized representative