

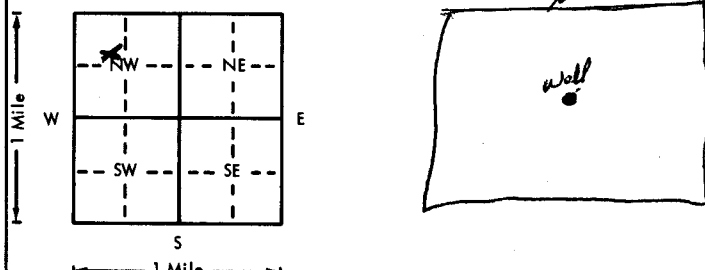
USE TYPEWRITER OR BALL  
POINT PEN-PRESS FIRMLY,  
PRINT CLEARLY.

MT. SURFLOWER NE

WATER WELL RECORD  
KSA 82a-1201-1215

Kansas Department of Health and  
Environment-Division of Environment  
(Water well Contractors)  
Topeka, Kansas 66620

BED BAC

1. Location of well: County <u>SHERMAN</u> Fraction <u>SE 1/4 NW 1/4</u> Section number <u>17</u> Township number <u>T 10 S</u> Range number <u>R 42 E</u>	
2. Distance and direction from nearest town or city: <u>10.5 IN 1/4 S</u> 3. Owner of well: <u>DELBERT WAIT</u> Street address of well location if in city: <u>KANORADO.</u> R.R. or street: City, state, zip code: <u>KANORADO KANSAS 67735</u>	
4. Locate with "X" in section below: Sketch map: 	
5. Type and color of material	
Clay Gravel & Sandstone	From 0 To 121
Gravel	121 123
Sandstone & Sandyclay	123 145
Gravel	145 148
Sandstone	148 149
Gravel	149 153
Sandyclay & Sandstone	153 190
Gravel	190 201
Sandstone & Gravel	201 213
Sand	213 229
Clay Sand & Sandstone	229 -251
Gravel	251 261
Soapstone	261 268
Shale	268 275
18. Elevation: 2550 19. Remarks: Concrete Run By Foust Supply Co.	
20. Water well contractor's certification: This well was drilled under my jurisdiction and this report is true to the best of my knowledge and belief. Business name <u>Foust Supply Co.</u> License No. <u>144</u> Address <u>Box 338 Goodland</u> Signed <u>Edith E. Foust</u> Date <u>2-25-77</u> Authorized representative	

10 42 0 17 SE NW NW