

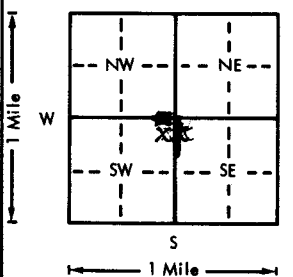
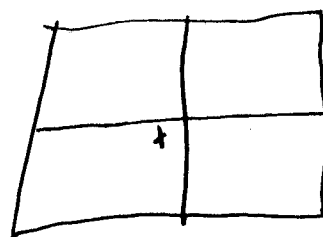
USE TYPEWRITER OR BALL  
POINT PEN-PRESS FIRMLY,  
PRINT CLEARLY.

MT. SUNFLOWER NE

WATER WELL RECORD  
KSA 82a-1201-1215

CAA

Kansas Department of Health and  
Environment-Division of Environment  
(Water well Contractors)  
Topeka, Kansas 66620

1. Location of well:		County <u>Sherman</u>	Fraction <u>Ne 1/4 Ne 1/4 Sw 1/4</u>	Section number <u>17</u>	Township number <u>T 10</u>	Range number <u>S R 42</u>
2. Distance and direction from nearest town or city: <u>11 S 1 W 1/2 N</u> Street address of well location if in city: <u>Of Kanorado Kans</u>				3. Owner of well: <u>Delbert Walt</u> R.R. or street: City, state, zip code: <u>Grinnell Kansas 67738</u>		
4. Locate with "X" in section below:		Sketch map:		6. Bore hole dia. <u>24</u> in. Completion date <u>4-13-77</u> Well depth <u>313</u> ft.		
				7. <input type="checkbox"/> Cable tool <input type="checkbox"/> Rotary <input type="checkbox"/> Driven <input type="checkbox"/> Dug <input type="checkbox"/> Hollow rod <input type="checkbox"/> Jetted <input type="checkbox"/> Bored <input checked="" type="checkbox"/> Reverse rotary		
5. Type and color of material				8. Use: <input type="checkbox"/> Domestic <input type="checkbox"/> Public supply <input type="checkbox"/> Industry <input checked="" type="checkbox"/> Irrigation <input type="checkbox"/> Air conditioning <input type="checkbox"/> Stock <input type="checkbox"/> Lawn <input type="checkbox"/> Oil field water <input type="checkbox"/> Other		
				9. Casing: Material <u>Steel</u> Height: <u>Above</u> or below Threaded <input type="checkbox"/> Welded <input checked="" type="checkbox"/> Surface <u>12</u> in. RMP <input type="checkbox"/> PVC <input type="checkbox"/> Weight <u>27</u> lbs./ft. Dia. <u>4 1/2</u> in. to <u>113</u> ft. depth Wall Thickness: inches or Dia. <u>  </u> in. to <u>  </u> ft. depth gage No. <u>188</u>		
				10. Screen: Manufacturer's name <u>W. A. Brown</u> Type <u>MILSLT</u> Dia. <u>1 1/2</u> Slot/gauze <u>1/8</u> Length <u>143</u> Set between <u>173</u> ft. and <u>316</u> ft. Gravel pack? <input checked="" type="checkbox"/> Size range of material <u>1/2"</u>		
				11. Static water level: <u>111</u> ft. below land surface Date <u>4-15-77</u> mo./day/yr.		
				12. Pumping level below land surfaces: <u>150</u> ft. after <u>6</u> hrs. pumping <u>600</u> g.p.m. <u>174</u> ft. after <u>16</u> hrs. pumping <u>1280</u> g.p.m. Estimated maximum yield <u>1280</u> g.p.m.		
				13. Water sample submitted: <u>  </u> mo./day/yr. Yes <input checked="" type="checkbox"/> No <input type="checkbox"/> Date <u>  </u>		
				14. Well head completion: <u>NO N.C.</u> <u>  </u> Pitless adapter <u>  </u> inches above grade		
				15. Well grouted? <input checked="" type="checkbox"/> With: <input checked="" type="checkbox"/> Neat cement <input type="checkbox"/> Bentonite <input type="checkbox"/> Concrete Depth: From <u>12" above 10 ft. Brown</u>		
				16. Nearest source of possible contamination: ft. <u>  </u> Direction <u>  </u> Well disinfected upon completion? Yes <input type="checkbox"/> No <input checked="" type="checkbox"/>		
				17. Pump: <u>Not installed</u> Manufacturer's name <u>TAIT HVC Pump</u> Model number <u>HA82077</u> HP <u>1 1/4</u> Volts <u>  </u> Length of drop pipe <u>300</u> ft. capacity <u>200</u> g.p.m. Type: <input type="checkbox"/> Submersible <input checked="" type="checkbox"/> Turbine <input type="checkbox"/> Jet <input type="checkbox"/> Reciprocating <input type="checkbox"/> Centrifugal <input type="checkbox"/> Other		
18. Elevation:				20. Water well contractor's certification: This well was drilled under my jurisdiction and this report is true to the best of my knowledge and belief. <u>Foust Supply Co Inc</u> <u>11/4</u> Business name <u>Box 338 Goodland Kans</u> License No. <u>  </u> Address <u>  </u> Signed <u>  </u> Date <u>5-1-77</u> Authorized representative		
19. Remarks: <u>Concrete Run 3975 (TUPO)</u> <u>By Foust Supply Co Inc.</u>						