


USE TYPEWRITER OR BALL POINT PEN—PRESS FIRMLY, PRINT CLEARLY.

WATER WELL RECORD
KSA 82a-1201-1215

Kansas Department of Health and Environment—Division of Environment
(Water well Contractors)
Topeka, Kansas 66620

DDIB

1. Location of well:		County <i>Sherman</i>	Fraction <i>NW 1/4 SE 1/4 SE 1/4</i>	Section number <i>23</i>	Township number T <i>10</i> S R <i>42</i> E <i>(W)</i>	Range number
2. Distance and direction from nearest town or city: <i>95 SW 33 of</i>			3. Owner of well: <i>Golden Wheat Ranch</i>			
Street address of well location if in city: <i>RALSTON, KANSAS.</i>			City, state, zip code: <i>Goodland Kansas</i>			
4. Locate with "X" in section below:		Sketch map:			6. Bore hole dia. <i>10 1/8</i> in. Completion date <i>6-23-77</i> Well depth <i>172</i> ft.	
					7. <input checked="" type="checkbox"/> Cable tool <input checked="" type="checkbox"/> Rotary <input type="checkbox"/> Driven <input type="checkbox"/> Dug <input type="checkbox"/> Hollow rod <input type="checkbox"/> Jetted <input type="checkbox"/> Bored <input type="checkbox"/> Reverse rotary	
5. Type and color of material		From	To	8. Use: <input checked="" type="checkbox"/> Domestic <input type="checkbox"/> Public supply <input type="checkbox"/> Industry <input type="checkbox"/> Irrigation <input type="checkbox"/> Air conditioning <input type="checkbox"/> Stock <input type="checkbox"/> Lawn <input type="checkbox"/> Oil field water <input type="checkbox"/> Other		
<i>Clay Gravel & Sandstone</i>		<i>0</i>	<i>103</i>	9. Casing: Material <i>Steel</i> Height: <i>Above or below</i> Threaded <input checked="" type="checkbox"/> Welded <input type="checkbox"/> Surface <i>8</i> in. RMP <input type="checkbox"/> PVC <input type="checkbox"/> Weight <i>17.36</i> lbs./ft. Dia. <i>8</i> in. to <i>150</i> ft. depth; Wall Thickness: inches or Dia. <input type="checkbox"/> in. to <input type="checkbox"/> ft. depth; gage No. <i>488</i>		
<i>Gravel</i>		<i>103</i>	<i>107</i>	10. Screen: Manufacturer's name <i>DARRCR</i> Type <i>Mill Saff</i> Dia. <i>4 1/2</i> Slot/gauze <i>1/32</i> Length <i>20</i> Set between <i>150</i> ft. and <i>170</i> ft. ft. and <input type="checkbox"/> ft. Gravel pack? <input checked="" type="checkbox"/> Size range of material <i>3/8 to 1/4</i>		
<i>Clay & Sandstone</i>		<i>107</i>	<i>125</i>	11. Static water level: <input type="checkbox"/> mo./day/yr. <i>60</i> ft. below land surface Date <i>5-26-77</i>		
<i>Gravel</i>		<i>125</i>	<i>126</i>	12. Pumping level below land surfaces: <i>80</i> ft. after <i>6</i> hrs. pumping <i>10</i> g.p.m. <i>80</i> ft. after <i>16</i> hrs. pumping <i>10</i> g.p.m. Estimated maximum yield <i>15</i> g.p.m.		
<i>Sandstone & Clay</i>		<i>126</i>	<i>138</i>	13. Water sample submitted: <input type="checkbox"/> mo./day/yr. <input type="checkbox"/> Yes <input checked="" type="checkbox"/> No Date <input type="checkbox"/>		
<i>Gravel</i>		<i>138</i>	<i>144</i>	14. Well head completion: <input checked="" type="checkbox"/> Pitless adapter <i>8</i> inches above grade		
<i>Sandstone</i>		<i>144</i>	<i>146</i>	15. Well grouted? <input checked="" type="checkbox"/> With: <input checked="" type="checkbox"/> Neat cement <input type="checkbox"/> Bentonite <input type="checkbox"/> Concrete Depth: From <i>6</i> ft. to <i>16</i> ft.		
<i>Gravel</i>		<i>146</i>	<i>165</i>	16. Nearest source of possible contamination: ft. <input type="checkbox"/> Direction <input type="checkbox"/> Type <input type="checkbox"/> Well disinfected upon completion? <input checked="" type="checkbox"/> Yes <input type="checkbox"/> No		
<i>Soapstone</i>		<i>165</i>	<i>172</i>	17. Pump: Manufacturer's name <i>Goulds</i> Not installed Model number <i>165310</i> HP <i>1 1/2</i> Volts <i>23</i> Length of drop pipe <i>147</i> ft. capacity <i>10</i> g.p.m. Type: <input checked="" type="checkbox"/> Submersible <input type="checkbox"/> Turbine <input type="checkbox"/> Jet <input type="checkbox"/> Reciprocating <input type="checkbox"/> Centrifugal <input type="checkbox"/> Other		
<i>Shale</i>		<i>172</i>		18. Elevation:		
<i>BRICK KEY</i>				19. Remarks: <i>3885 (TOP)</i> <i>Concrete was Run</i> <i>By Foust Supply Co</i>		
20. Water well contractor's certification: This well was drilled under my jurisdiction and this report is true to the best of my knowledge and belief.		<i>Foust Supply Co</i> License No. <i>144</i> Business name <i>165310</i> HP <i>1 1/2</i> Volts <i>23</i> Address <i>Box 338 Goodland, Kansas</i> Signed <i>Ralph E. Foust</i> Date <i>6-20-77</i> Authorized representative				

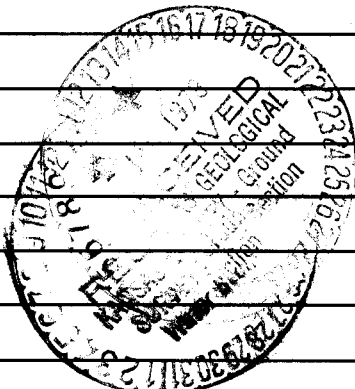

T 10
 R 42
 E 23
 S 1/4 NW SE SE
 Sec 23