

CORRECTION TO WATER WELL RECORD (WWC-5)

The following correction(s) was made to the attached WWC-5 log, in order to file the item or to rectify lacking or incorrect information.

Fraction ( 1/4 1/4 1/4) Section-Township-Range changed:

listed as NE NE NE, 28-10S

changed to NE NE NE, 28-10S-5W

Other changes: Initial statements: \_\_\_\_\_

Changed to: \_\_\_\_\_

Comments: \_\_\_\_\_

verification method: Written & legal descriptions, and


Ada 1:24,000 topo map. initials: DRL date: 5/3/2001

submitted by: Kansas Geological Survey, Data Resources Library, 1930 Constant Ave., Lawrence, KS 66047-3726  
to: Kansas Dept of Health & Environment Bureau of Water Industrial Programs, Bldg 283, Forbes Field, KS 66620

1 LOCATION OF WATER WELL: Fraction NE 1/4 NE 1/4 NE 1/4 Section Number 28 Township Number T 10 S Range Number R E/W  
 County: Ottawa

Distance and direction from nearest town or city street address of well if located within city?  
1 mile East & 1/2 mile North of Ada, KS

2 WATER WELL OWNER: John Boucek  
 RR#, St. Address, Box #: 1555 N. 30th Rd. Board of Agriculture, Division of Water Resources  
 City, State, ZIP Code: Ada, KS 67414 Application Number:

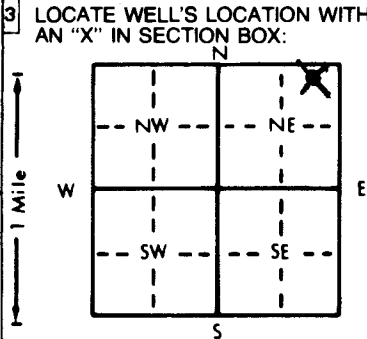

4 DEPTH OF COMPLETED WELL: 138 ft. ELEVATION:  
 Depth(s) Groundwater Encountered 1. .... ft. 2. .... ft. 3. .... ft.  
 WELL'S STATIC WATER LEVEL 44 ft. below land surface measured on mo/day/yr 9/17/98  
 Pump test data: Well water was 1.25 ft. after 4 hours pumping 220 gpm  
 Est. Yield 250 gpm: Well water was .... ft. after .... hours pumping .... gpm  
 Bore Hole Diameter 3.0 in. to 138 ft., and .... in. to .... ft.  
 WELL WATER TO BE USED AS: 5 Public water supply 8 Air conditioning 11 Injection well  
 1 Domestic 3 Feedlot 6 Oil field water supply 9 Dewatering 1X Other (Specify below)  
2 Irrigation 4 Industrial 7 Lawn and garden only 10 Monitoring well Stockwell  
 Was a chemical/bacteriological sample submitted to Department? Yes.....No.....X...; If yes, mo/day/yr sample was submitted Water Well Disinfected? Yes X No

5 TYPE OF BLANK CASING USED: 5 Wrought iron 8 Concrete tile CASING JOINTS: Glued X Clamped  
 1 Steel 3 RMP (SR) 6 Asbestos-Cement 9 Other (specify below) Welded  
X PVC 4 ABS 7 Fiberglass Threaded  
 Blank casing diameter 1.6 in. to 78 ft., Dia. .... in. to .... ft., Dia. .... in. to .... ft.  
 Casing height above land surface 1.2 in., weight 16.15 lbs./ft. Wall thickness or gauge No. 500  
 TYPE OF SCREEN OR PERFORATION MATERIAL: X7 PVC 10 Asbestos-cement  
 1 Steel 3 Stainless steel 5 Fiberglass 8 RMP (SR) 11 Other (specify) ....  
 2 Brass 4 Galvanized steel 6 Concrete tile 9 ABS 12 None used (open hole)  
 SCREEN OR PERFORATION OPENINGS ARE: 5 Gauzed wrapped 8 Saw cut 11 None (open hole)  
 1 Continuous slot X Mill slot 6 Wire wrapped 9 Drilled holes  
 2 Louvered shutter 4 Key punched 7 Torch cut 10 Other (specify) ....  
 SCREEN-PERFORATED INTERVALS: From 78 ft. to 138 ft., From .... ft. to .... ft.  
 From .... ft. to .... ft., From .... ft. to .... ft.  
 GRAVEL PACK INTERVALS: From 20 ft. to 138 ft., From .... ft. to .... ft.  
 From .... ft. to .... ft., From .... ft. to .... ft.

6 GROUT MATERIAL: 1 Neat cement X2 Cement grout 3 Bentonite 4 Other  
 Grout Intervals: From 0 ft. to 20 ft., From .... ft. to .... ft., From .... ft. to .... ft.  
 What is the nearest source of possible contamination: none within 1/4 mile 10 Livestock pens 14 Abandoned water well  
 1 Septic tank 4 Lateral lines 7 Pit privy 11 Fuel storage 15 Oil well/Gas well  
 2 Sewer lines 5 Cess pool 8 Sewage lagoon 12 Fertilizer storage 16 Other (specify below)  
 3 Watertight sewer lines 6 Seepage pit 9 Feedyard 13 Insecticide storage

Direction from well? How many feet?

FROM	TO	LITHOLOGIC LOG	FROM	TO	PLUGGING INTERVALS
0	3	Top Soil			
3	10	White Clay & Shale			
10	18	Sandrock and Gray Shale			
18	40	Tan Soft Sandstone			
40	85	Gray Hard Shale			
85	138	White to Tan Hard Sandstone			
138		Gray Shale			

7 CONTRACTOR'S OR LANDOWNER'S CERTIFICATION: This water well was X1 constructed, (2) reconstructed, or (3) plugged under my jurisdiction and was completed on (mo/day/year) 9/17/98 and this record is true to the best of my knowledge and belief. Kansas Water Well Contractor's License No. 138 This Water Well Record was completed on (mo/day/yr) 10/8/98 under the business name of Peterson Irrigation, Inc. by (signature) Mike Peterson

INSTRUCTIONS: Use typewriter or ball point pen. PLEASE PRESS FIRMLY and PRINT clearly. Please fill in blanks, underline or circle the correct answers. Send top three copies to Kansas Department of Health and Environment, Bureau of Water, Topeka, Kansas 66620-0001. Telephone: 913-296-5545. Send one to WATER WELL OWNER and retain one for your records.

OFFICE USE ONLY  
T  
R  
E/W  
SEC.  
1/4  
1/4  
1/4