


1 LOCATION OF WATER WELL: Fraction SE 1/4 SE 1/4 SE 1/4 Section Number 32 Township Number T 10 S Range Number R 5

Distance and direction from nearest town or city street address of well if located within city?

1 1/4 miles South of Ada, KS

2 WATER WELL OWNER: Ottawa RWD #1  
 RR#, St. Address, Box # : c/o Schwaab-Eaton  
 City, State, ZIP Code : Manhattan, KS 66502  
 Board of Agriculture, Division of Water Resources  
 Application Number: 38937

3 LOCATE WELL'S LOCATION WITH AN "X" IN SECTION BOX:  
 4 DEPTH OF COMPLETED WELL: 95 ft. ELEVATION:  
 Depth(s) Groundwater Encountered 1. 54 ft. 2. ft. 3. ft.

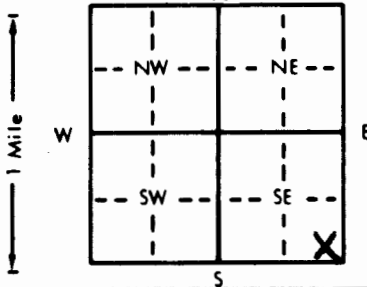

WELL'S STATIC WATER LEVEL: 54 ft. below land surface measured on mo/day/yr 11-23-88  
 Pump test data: Well water was ft. after hours pumping gpm  
 Est. Yield 70 gpm: Well water was 65 ft. after 5 hours pumping 70 gpm  
 Bore Hole Diameter: 10 in. to 95 ft., and in. to ft.  
 WELL WATER TO BE USED AS:  
 1 Domestic 3 Feedlot 6 Oil field water supply 9 Dewatering 11 Injection well  
 2 Irrigation 4 Industrial 7 Lawn and garden only 10 Observation well 12 Other (Specify below)  
 Was a chemical/bacteriological sample submitted to Department? Yes No X; If yes, mo/day/yr sample was submitted  
 Water Well Disinfected? Yes X No

5 TYPE OF BLANK CASING USED:  
 1 Steel 3 RMP (SR) 5 Wrought iron 8 Concrete tile CASING JOINTS: Glued Clamped  
 2 PVC 4 ABS 6 Asbestos-Cement 9 Other (specify below) Welded  
 7 Fiberglass Threaded

Blank casing diameter 6 in. to ft., Dia 3 ft. to 85 ft., Dia in. to ft.  
 Casing height above land surface 12 in., weight 3.52 lbs./ft. Wall thickness or gauge No. 255

TYPE OF SCREEN OR PERFORATION MATERIAL:  
 1 Steel 3 Stainless steel 5 Fiberglass 7 PVC 10 Asbestos-cement  
 2 Brass 4 Galvanized steel 6 Concrete tile 8 RMP (SR) 11 Other (specify)  
 12 None used (open hole)

SCREEN OR PERFORATION OPENINGS ARE:  
 1 Continuous slot 3 Mill slot 5 Gauzed wrapped 8 Saw cut 11 None (open hole)  
 2 Louvered shutter 4 Key punched 6 Wire wrapped 9 Drilled holes  
 7 Torch cut 10 Other (specify)

SCREEN-PERFORATED INTERVALS: From 85 ft. to 95 ft., From ft. to ft.  
 From ft. to ft., From ft. to ft.  
 GRAVEL PACK INTERVALS: From 20 ft. to 95 ft., From ft. to ft.  
 From ft. to ft., From ft. to ft.

6 GROUT MATERIAL: 1 Neat cement 2 Cement grout 3 Bentonite 4 Other  
 Grout Intervals: From 4 ft. to 25 ft., From ft. to ft., From ft. to ft.

What is the nearest source of possible contamination:  
 1 Septic tank 4 Lateral lines 7 Pit privy 10 Livestock pens 14 Abandoned water well  
 2 Sewer lines 5 Cess pool 8 Sewage lagoon 11 Fuel storage 15 Oil well/Gas well  
 3 Watertight sewer lines 6 Seepage pit 9 Feedyard 12 Fertilizer storage 16 Other (specify below)  
 13 Insecticide storage

Direction from well? North East How many feet? 1600

| FROM | TO | LITHOLOGIC LOG        | FROM | TO | LITHOLOGIC LOG |
|------|----|-----------------------|------|----|----------------|
| 0    | 3  | Top Soil              |      |    |                |
| 3    | 6  | Sandy White Clay      |      |    |                |
| 6    | 60 | Brown Sandstone       |      |    |                |
| 60   | 62 | Gray Shale            |      |    |                |
| 62   | 68 | Brown Sandstone       |      |    |                |
| 68   | 72 | Gray Shale            |      |    |                |
| 72   | 96 | Light Brown Sandstone |      |    |                |

7 CONTRACTOR'S OR LANDOWNER'S CERTIFICATION: This water well was (1) constructed, (2) reconstructed, or (3) plugged under my jurisdiction and was completed on (mo/day/year) 11-23-88 and this record is true to the best of my knowledge and belief. Kansas Water Well Contractor's License No. 138. This Water Well Record was completed on (mo/day/yr) DEC. 12, 1988 under the business name of Peterson Irrigation, Inc. by (signature) Mike Peterson

INSTRUCTIONS: Use typewriter or ball point pen. PLEASE PRESS FIRMLY and PRINT clearly. Please fill in blanks, underline or circle the correct answers. Send top three copies to Kansas Department of Health and Environment, Bureau of Water Protection, Topeka, Kansas 66620-7320, Telephone: 913-862-9360. Send one to WATER WELL OWNER and retain one for your records.