


1 LOCATION OF WATER WELL: Fraction NE 1/4 NW 1/4 NE 1/4 Section Number 34 Township Number T 11 S Range Number R 11 EW

Distance and direction from nearest town or city street address of well if located within city? 5499 K-18, Lucas, Kansas

2 WATER WELL OWNER: Home Oil & Convenience Store, Inc. RR#, St. Address, Box #: P.O. Box 38 City, State, ZIP Code: Lucas, Kansas 67648 Board of Agriculture, Division of Water Resources Application Number:

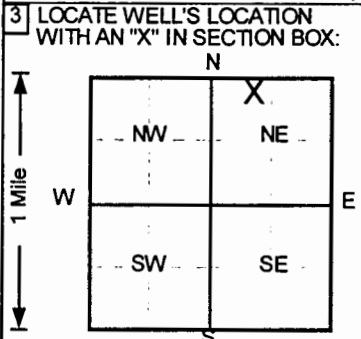

3 LOCATE WELL'S LOCATION WITH AN 'X' IN SECTION BOX: 4 DEPTH OF COMPLETED WELL: 40 ft. ELEVATION: 1493.58. WELL'S STATIC WATER LEVEL: 28.84 ft below land surface measured on 12/11/97. Pump test data: Well water was NA ft after NA hours pumping NA gpm. Est. Yield NA gpm. Bore Hole Diameter 8 in. to 40 in. WELL WATER TO BE USED AS: 10 Monitoring well. Was a chemical/bacteriological sample submitted? Yes No. Water Well Disinfected? Yes No.

5 TYPE OF BLANK CASING USED: 2 PVC. Blank casing diameter 2 in. to 25 ft, Dia. Casing height above land surface -3.84 in., weight Sch 40. TYPE OF SCREEN OR PERFORATION MATERIAL: 7 PVC. SCREEN OR PERFORATION OPENINGS ARE: 3 Mill slot. SCREEN-PERFORATED INTERVALS: From 25 ft to 40 ft. GRAVEL PACK INTERVALS: From 23 ft to 40 ft.

6 GROUT MATERIAL: 2 Cement grout, 3 Bentonite. Grout intervals: From 0 ft to 21 ft, From 21 ft to 23 ft. What is the nearest source of possible contamination: 16 Other (specify below) Former Tank Basin. Direction from well? Northeast. How many feet? 160.

Table with columns: FROM, TO, LITHOLOGIC LOG, FROM, TO, PLUGGING INTERVALS. Rows include: 0-0.5 Asphalt, 0.5-2 Clay, Dark Brown, 2-20 Clay, Light Brown, 20-40 Sand, Red Brown. Bottom row: MW11, Tag # 00191715, Flushmount; Project Name: Lucas Home Oil -Convenience Store; GeoCore # 493, KDHE # A6 084 40025.

7 CONTRACTOR'S OR LANDOWNER'S CERTIFICATION: This water well was (1) constructed, (2) reconstructed, or (3) plugged under my jurisdiction and was completed on (mo/day/year) 11/5/97 and this record is true to the best of my knowledge and belief. Kansas Water Well Contractor's License No. 527. This Water Well Record was completed on (mo/day/yr) under the business name of GeoCore Services, Inc. by (signature) Paul Kohl.

INSTRUCTIONS: Use typewriter or ball point pen. PLEASE PRESS FIRMLY and PRINT clearly. Please fill in blanks, underline or circle the correct answers. Send top three copies to Kansas Department of Health and Environment, Bureau of Water, Topeka, Kansas 66620-0001. Telephone: 913-296-5545. Send one to WATER WELL OWNER and retain one for your records.

OFFICE USE ONLY

T

R

EW

SEC.

1/4

1/4

1/4