


1 LOCATION OF WATER WELL: Fraction SE 1/4 SE 1/4 SE 1/4 Section Number 29 Township Number Fairview 11 Range Number 11 EW
 County: Russell

Distance and direction from nearest town or city street address of well if located within city?

2 WATER WELL OWNER: City of Lucas
 RR #, St. Address, Box #: PO Box 308 Board of Agriculture, Division of Water Resources
 City, State, ZIP Code: Lucas KS 67648-0308 Application Number: —

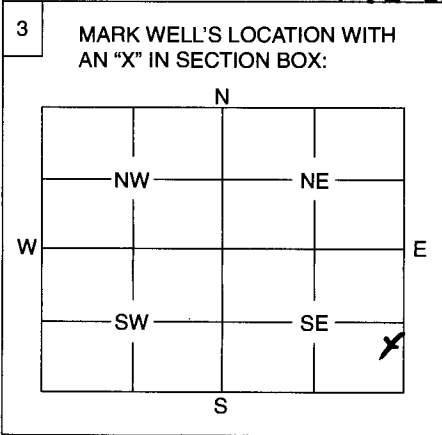

4 DEPTH OF WELL 6.4 ft.
 WELL'S STATIC WATER LEVEL 3.4 ft.
 WELL WAS USED AS:
 1 Domestic 5 Public Water Supply 9 Dewatering
 2 Irrigation 6 Oil Field Water Supply 10 Monitoring Well
 3 Feedlot 7 Domestic (Lawn & Garden) 11 Injection Well
 4 Industrial 8 Air Conditioning 12 Other Test
 Was a chemical / bacteriological sample submitted to Department? Yes No X.....
 If yes, mo/day/yr sample was submitted
 Water Well Disinfected: Yes X No

5 TYPE OF BLANK CASING USED:
 1 Steel 3 RMP (SR) 5 Wrought 7 Fiberglass 9 Other (Specify below)
3 PVC 4 ABS 6 Asbestos-Cement 8 Concrete Tile
 Blank casing diameter 2 in. Was casing pulled? Yes No X..... If yes, how much
 Casing height above or below land surface Below 4.8" in.

6 GROUT PLUG MATERIAL: 1 Neat cement 2 Cement grout 3 Benionite 4 Other Chlorinated sand
 Grout Plug Intervals: From 6.4 ft. to 8 ft., From 8 ft. to 4 ft., From 4 to 0 ft.
 What is the nearest source of possible contamination:
 1 Septic tank 6 Seepage pit 11 Fuel storage 16 Other (specify below)
 2 Sewer lines 7 Pit privy 12 Fertilizer storage None
 3 Watertight sewer lines 8 Sewage lagoon 13 Insecticide storage
 4 Lateral lines 9 Feedyard 14 Abandoned water well
 5 Cess pool 10 Livestock pens 15 Oil well/Gas well
 Direction from well? How many feet?

FROM	TO	PLUGGING MATERIALS
<u>6.4</u>	<u>8</u>	<u>Chlorinated sand</u>
<u>8</u>	<u>4</u>	<u>Neat Cement</u>
<u>4</u>	<u>0</u>	<u>Dirt</u>

7 CONTRACTOR'S OR LANDOWNER'S CERTIFICATION: This water well was plugged under my jurisdiction and was completed on (mo/day/year) None and this record is true to the best of my knowledge and belief. Kansas Water Well Contractor's License No. None City of Lucas. This Water Well Record was completed on (mo/day/year) 4/23/04 under the business name of City of Lucas by (signature) Richard W. [Signature]

INSTRUCTIONS: Use typewriter or ball point pen. Please press firmly and print clearly. Please fill in blanks, underline or circle the correct answers. Send top three copies to Kansas Department of Health and Environment, Bureau of Water, Geology Section, 1000 SW Jackson St., Ste. 420, Topeka, Kansas 66612-1367. Telephone: 785/296-5522. Send one to Water Well Owner and retain one for your records.