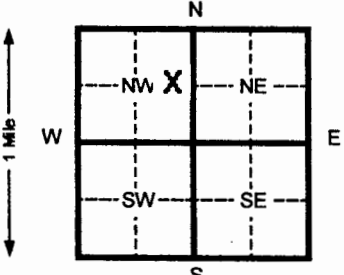


1 LOCATION OF WATER WELL: County: Russell	Fraction SE ¼ NW ¼ NW ¼	Section Number 34	Township Number T 11 S	Range Number R 11 E N	
Distance and direction from nearest town or city street address of well if located within city? 120 N. Harvest, Lucas, Ks	
2 WATER WELL OWNER: Elmer D. Svaty RR#, St. Address, Box # : Quality Oil, 409 E. 1st St City, State, ZIP Code : Lucas, Ks	
Board of Agriculture, Division of Water Resources Application Number:	
3 LOCATE WELL'S LOCATION WITH AN "X" IN SECTION BOX: 		4 DEPTH OF COMPLETED WELL 35 ft. ELEVATION: Depth(s) Groundwater Encountered 1 _____ ft. 2 _____ ft. 3 _____ ft. WELL'S STATIC WATER LEVEL _____ ft. below land surface measured on mo/day/yr Pump test data: Well water was _____ ft. after _____ hours pumping _____ gpm Est. Yield _____ gpm: Well water was _____ ft. after _____ hours pumping _____ gpm Bore Hole Diameter 8 in. to 35 ft. and _____ in. to _____ ft. WELL WATER TO BE USED AS: 5 Public water supply 8 Air conditioning 11 Injection well 1 Domestic 3 Feed lot 6 Oil field water supply 9 Dewatering 12 Other (Specify below) 2 Irrigation 4 Industrial 7 Lawn and garden (domestic) <input checked="" type="checkbox"/> Monitoring well Was a chemical/bacteriological sample submitted to Department? Yes _____ No <input checked="" type="checkbox"/> If yes, mo/day/yr sample was submitted _____ Water Well Disinfected? Yes _____ No <input checked="" type="checkbox"/>	
5 TYPE OF BLANK CASING USED: 1 Steel 3 RMP (SR) 5 Wrought iron 8 Concrete tile CASING JOINTS: Glued _____ Clamped _____ <input checked="" type="checkbox"/> PVC 4 ABS 6 Asbestos-Cement 9 Other (specify below) Welded _____ 7 Fiberglass Threaded <input checked="" type="checkbox"/> Blank casing diameter 2 in. to 31 ft. Dia _____ in. to _____ ft. Dia _____ in. to _____ ft. Casing height above land surface 0 in., weight .716 lbs./ft. Wall thickness or gauge No. .154 TYPE OF SCREEN OR PERFORATION MATERIAL: 1 Steel 3 Stainless steel 5 Fiberglass 8 RMP (SR) 10 Asbestos-cement 2 Brass 4 Galvanized steel 6 Concrete tile 9 ABS 11 Other (specify) _____ 12 None used (open hole) SCREEN OR PERFORATION OPENINGS ARE: 1 Continuous slot 3 Mill slot 5 Gauzed wrapped <input checked="" type="checkbox"/> Saw cut 11 None (open hole) 2 Louvered shutter 4 Key punched 6 Wire wrapped 9 Drilled holes 7 Torch cut 10 Other (specify) _____ SCREEN-PERFORATED INTERVALS: From 31 ft. to 33 ft. From _____ ft. to _____ ft. From _____ ft. to _____ ft. From _____ ft. to _____ ft. GRAVEL PACK INTERVALS: From 29 ft. to 35 ft. From _____ ft. to _____ ft. From _____ ft. to _____ ft. From _____ ft. to _____ ft.	
6 GROUT MATERIAL: 1 Neat cement 2 Cement grout <input checked="" type="checkbox"/> Bentonite 4 Other _____ Grout Intervals From 3 ft. to 29 ft. From _____ ft. to _____ ft. From _____ ft. to _____ ft. What is the nearest source of possible contamination: 1 Septic tank 4 Lateral lines 7 Pit privy 10 Livestock pens 14 Abandoned water well 2 Sewer lines 5 Cess pool 8 Sewage lagoon 11 Fuel storage 15 Oil well/ Gas well 3 Watertight sewer lines 6 Seepage pit 9 Feedyard 12 Fertilizer storage 16 Other (specify below) Contaminated site Direction from well? _____ How many feet? _____	
<table border="1" style="width:100%; border-collapse: collapse;"> <thead> <tr> <th>FROM</th> <th>TO</th> <th>CODE</th> <th>LITHOLOGIC LOG</th> <th>FROM</th> <th>TO</th> <th>PLUGGING INTERVALS</th> </tr> </thead> <tbody> <tr> <td>0</td> <td>.5</td> <td></td> <td>grass, soil</td> <td></td> <td></td> <td></td> </tr> <tr> <td>.5</td> <td>6</td> <td></td> <td>Fill sand, very fine grained, Loose</td> <td></td> <td></td> <td></td> </tr> <tr> <td>6</td> <td>10</td> <td></td> <td>Silty clay to clayey silt</td> <td></td> <td></td> <td></td> </tr> <tr> <td>10</td> <td>15</td> <td></td> <td>Silty clay to clayey silt</td> <td></td> <td></td> <td></td> </tr> <tr> <td>15</td> <td>28</td> <td></td> <td>Fine to very fine grained sand Silty, some gravel</td> <td></td> <td></td> <td></td> </tr> <tr> <td>38</td> <td>33</td> <td></td> <td>Fine to medium grained sand, Abundant gravel</td> <td></td> <td></td> <td></td> </tr> <tr> <td>33</td> <td>35</td> <td></td> <td>Sandstone, weathered as above Very hard</td> <td></td> <td></td> <td></td> </tr> </tbody> </table>					FROM	TO	CODE	LITHOLOGIC LOG	FROM	TO	PLUGGING INTERVALS	0	.5		grass, soil				.5	6		Fill sand, very fine grained, Loose				6	10		Silty clay to clayey silt				10	15		Silty clay to clayey silt				15	28		Fine to very fine grained sand Silty, some gravel				38	33		Fine to medium grained sand, Abundant gravel				33	35		Sandstone, weathered as above Very hard			
FROM	TO	CODE	LITHOLOGIC LOG	FROM	TO	PLUGGING INTERVALS	
0	.5		grass, soil	
.5	6		Fill sand, very fine grained, Loose	
6	10		Silty clay to clayey silt	
10	15		Silty clay to clayey silt	
15	28		Fine to very fine grained sand Silty, some gravel	
38	33		Fine to medium grained sand, Abundant gravel	
33	35		Sandstone, weathered as above Very hard	
7 CONTRACTOR'S OR LANDOWNER'S CERTIFICATION: This water well was (1) <input checked="" type="checkbox"/> constructed, (2) reconstructed, or (3) plugged under my jurisdiction and was completed on (mo/day/yr) 3-0905 and this record is true to the best of my knowledge and belief. Kansas Water Well Contractor's License No. 554 This Water Well Record was completed on (mo/day/yr) 4-8-05 under the business name of Woofter Pump & Well Inc. by (signature) <i>Elmer D. Svaty</i>	
INSTRUCTIONS: Please fill in blanks and circle the correct answers. Send three copies to Kansas Department of Health and Environment, Bureau of Water, 1000 S W Jackson St., Ste. 420, Topeka, Kansas 66612-1367. Telephone: 913-296-5545. Send one to WATER WELL OWNER and retain one for your records.	

OFFICE USE ONLY

T

R

SEC