WATER WELL RECORD Form WWC-5 KSA 82a-1212 ID No. **AS-17**

**1 LOCATION OF WATER WELL:**

| County: | Fraction | Section Number | Township Number | Range Number |
|---|---|---|---|---|
| **Russell** | **SE** ¼ **NW** ¼ **NW** ¼ | **34** | T **11** S | R **11** E/W |

Distance and direction from nearest town or city street address of well if located within city?
**120 N. Harvest, Lucas, Ks**

**2 WATER WELL OWNER:** **Elmer D. Svaty**
RR#, St. Address, Box # : **Quality Oil, 409 E. 1st St**
City, State, ZIP Code : **Lucas, Ks**

Board of Agriculture, Division of Water Resources
Application Number:

**3 LOCATE WELL'S LOCATON WITH AN "X" IN SECTION BOX:**

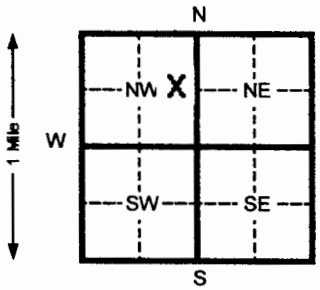


**4 DEPTH OF COMPLETED WELL** **35** ft. ELEVATION:
Depth(s) Groundwater Encountered 1 ____ ft. 2 ____ ft. 3 ____ ft.
WELL'S STATIC WATER LEVEL ____ ft. below land surface measured on mo/day/yr ____
Pump test data: Well water was ____ ft. after ____ hours pumping ____ gpm
Est. Yield ____ gpm: Well water was ____ ft. after ____ hours pumping ____ gpm
Bore Hole Diameter **8** in. to **36** ft. and ____ in. to ____ ft.
WELL WATER TO BE USED AS: 1 Domestic 2 Irrigation 3 Feed lot 4 Industrial 5 Public water supply 6 Oil field water supply 7 Lawn and garden (domestic) 8 Air conditioning 9 Dewatering (10) Monitoring well 11 Injection well 12 Other (Specify below)
Was a chemical/bacteriological sample submitted to Department? Yes ____ No **X** If yes, mo/day/yr sample was submitted
Water Well Disinfected? Yes ____ No **X**

**5 TYPE OF BLANK CASING USED:** 1 Steel (2) PVC 3 RMP (SR) 4 ABS 5 Wrought Iron 6 Asbestos-Cement 7 Fiberglass 8 Concrete tile 9 Other (specify below)
CASING JOINTS: Glued ____ Clamped ____ Welded ____ Threaded **X**
Blank casing diameter **2** in. to **33** ft., Dia **35** in. to ____ ft., Dia ____ in. to ____ ft.
Casing height above land surface **0** in., weight **.716** lbs./ft. Wall thickness or gauge No. **.154**
TYPE OF SCREEN OR PERFORATION MATERIAL: 1 Steel 2 Brass 3 Stainless steel 4 Galvanized steel 5 Fiberglass 6 Concrete tile (7) PVC 8 RMP (SR) 9 ABS 10 Asbestos-cement 11 Other (specify) ____ 12 None used (open hole)
SCREEN OR PERFORATION OPENINGS ARE: 1 Continuous slot 2 Louvered shutter 3 Mill slot 4 Key punched 5 Gauzed wrapped 6 Wire wrapped 7 Torch cut (8) Saw cut 9 Drilled holes 10 Other (specify) ____ 11 None (open hole)
SCREEN-PERFORATED INTERVALS: From **33** **35** ft. From ____ ft. to ____ ft.
From ____ ft. to ____ ft. From ____ ft. to ____ ft.
GRAVEL PACK INTERVALS: From **31** ft. to **36** ft. From ____ ft. to ____ ft.
From ____ ft. to ____ ft. From ____ ft. to ____ ft.

**6 GROUT MATERIAL:** 1 Neat cement 2 Cement grout [3 Bentonite] 4 Other ____
Grout Intervals From **3** ft. to **31** ft. From ____ ft. to ____ ft. From ____ ft. to ____ ft.
What is the nearest source of possible contamination:
1 Septic tank 2 Sewer lines 3 Watertight sewer lines 4 Lateral lines 5 Cess pool 6 Seepage pit 7 Pit privy 8 Sewage lagoon 9 Feedyard 10 Livestock pens 11 Fuel storage 12 Fertilizer storage 13 Insecticide storage 14 Abandoned water well 15 Oil well/ Gas well 16 Other (specify below) **Contaminated site**
Direction from well? How many feet?

| FROM | TO | CODE | LITHOLOGIC LOG | FROM | TO | PLUGGING INTERVALS |
|---|---|---|---|---|---|---|
| 0 | 2 | | grass, soil | | | |
| 2 | 12 | | Silty clay to clayey silt | | | |
| 12 | 35 | | Silty clay to clayey silt | | | |
| 35 | 36 | | siltstone | | | |

**7 CONTRACTOR'S OR LANDOWNER'S CERTIFICATION:** This water well was (1) constructed, (2) reconstructed, or (3) plugged under my jurisdiction and was completed on (mo/day/yr) **3-07-05** and this record is true to the best of my knowledge and belief. Kansas Water Well Contractor's License No. **554** This Water Well Record was completed on (mo/day/yr) **4-8-05**
under the business name of **Woofter Pump & Well Inc.** by (signature) [signature]

INSTRUCTIONS:. Please fill in blanks and circle the correct answers. Send three copies to Kansas Department of Health and Environment/ Bureau of Water, 1000 S W Jackson St., Ste. 420, Topeka, Kansas 66612-1367. Telephone: 913-296-5545. Send one to WATER WELL OWNER and retain one for your records.

OFFICE USE ONLY T R SEC

Form provided by Forms-On-A-Disk, Inc. · Dallas, Texas · (214) 340-9429