

**WATER WELL PLUGGING RECORD**

Form WWC-5P

KSA 82a-1212


ID No.

AS-9

<b>1</b> LOCATION OF WATER WELL:	Fraction	Section Number	Township Number	Range Number
County: Russell	SE 1/4 NW 1/4 NW 1/4	34	11S	11W

Distance and direction from nearest town or city street address of well if located within city?  
120 Harvest Road, Lucas, KS

**2** WATER WELL OWNER: Quality Oil Company  
 RR#, St. Address, Box # 409 E. First  
 City, State, ZIP Code : Lucas, KS 67648  
 Board of Agriculture, Division of Water Resources  
 Application Number:

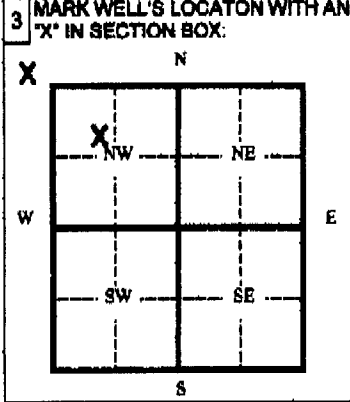

**4** DEPTH OF WELL ..... 32 ..... ft.  
 WELL'S STATIC WATER LEVEL ..... 29.1 ..... ft.  
 WELL WAS USED AS:  
 1 Domestic                      5 Public Water Supply                      9 Dewatering  
 2 Irrigation                      6 Oil Field Water Supply                      10 Monitoring Well  
 3 Feedlot                          7 Lawn and Garden (domestic)                      11 Injection Well  
 4 Industrial                      8 Air Conditioning                          12 Other .....

Was a chemical/bacteriological sample submitted to Department? Yes ..... No .....  
 If yes, mo/day/yr sample was submitted .....

Water Well Disinfected: Yes ..... No .....

**5** TYPE OF BLANK CASING USED:  
 1 Steel                      3 RMP (SR)                      5 Wrought                      7 Fiberglass                      9 Other (specify below)  
 2 PVC                      4 ABC                      6 Asbestos-Cement                      8 Concrete Tile

Blank casing diameter ..... 2 ..... in. Was casing pulled? Yes x No                      If yes, how much ..... 3 feet .....

Casing height above or below land surface ..... in.

**6** GROUT PLUG MATERIAL: 1 Neat cement    2 Cement grout    3 Bentonite    4 Other .....

Grout Plug Intervals From ..... ft. to ..... ft. From ..... ft. to ..... ft. From ..... ft. to ..... ft.

What is the nearest source of possible contamination:

1 Septic tank                      6 Seepage pit                      11 Fuel storage                      16 Other (specify below)  
 2 Sewer lines                      7 Pit privy                      12 Fertilizer storage  
 3 Watertight sewer lines                      8 Sewage lagoon                      13 Insecticide storage  
 4 Lateral lines                      9 Feedyard                      14 Abandoned water well  
 5 Cess Pool                      10 Livestock pens                      15 Oil well/ Gas well

Direction from well? ..... How many feet? .....

FROM	TO	CODE	PLUGGING MATERIALS
0	3		Native fill
3	32		Bentonite chips

**7** CONTRACTOR'S OR LANDOWNER'S CERTIFICATION: This water well was plugged under my jurisdiction and was completed on (mo/day/yr) ..... 12/10/14 ..... and this record is true to the best of my knowledge and belief. Kansas Water Well Contractor's License No. ..... 12/15/14 ..... This Water Well Record was completed on (mo/day/yr) ..... under the business name of ..... Bluestem Environmental Engineering, Inc. by (signature) *Nick Holt* .....

**INSTRUCTIONS:** Please fill in blanks and circle the correct answers. Send three copies to Kansas Department of Health and Environment, Bureau of Water, 1000 S W Jackson St., Ste. 420, Topeka, Kansas 66620-0001. Telephone: 785-296-3565. Send one to Water Well Owner and retain one for your records.