

**WATER WELL PLUGGING RECORD**

Form WWC-5P

KSA 82a-1212

ID No.

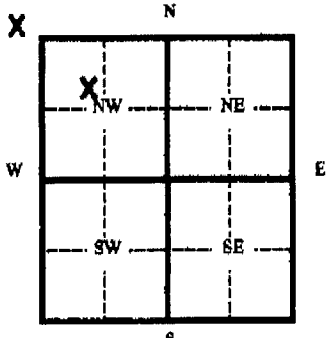
AS-8

<b>1</b> LOCATION OF WATER WELL:	Fraction	Section Number	Township Number	Range Number
County: Russell	SE 1/4 NW 1/4 NW 1/4	34	11S	11W

Distance and direction from nearest town or city street address of well if located within city?  
120 Harvest Road, Lucas, KS

**2** WATER WELL OWNER: Quality Oil Company  
RR#, St. Address, Box # 409 E. First  
City, State, ZIP Code : Lucas, KS 67648

Board of Agriculture, Division of Water Resources  
Application Number:

<b>3</b> MARK WELL'S LOCATION WITH AN "X" IN SECTION BOX: 	<b>4</b> DEPTH OF WELL 36 ft.
	WELL'S STATIC WATER LEVEL 29 ft.

WELL WAS USED AS:

1 Domestic	5 Public Water Supply	9 Dewatering
2 Irrigation	6 Oil Field Water Supply	10 Monitoring Well
3 Feedlot	7 Lawn and Garden (domestic)	<b>11</b> Injection Well
4 Industrial	8 Air Conditioning	12 Other

Was a chemical/bacteriological sample submitted to Department? Yes ... No ...  
If yes, mo/day/yr sample was submitted \_\_\_\_\_  
Water Well Disinfected: Yes ... No ...

**5** TYPE OF BLANK CASING USED:

1 Steel	3 RMP (SR)	5 Wrought	7 Fiberglass	9 Other (specify below)
<b>2</b> PVC	4 ABC	6 Asbestos-Cement	8 Concrete Tile	

Blank casing diameter 2 in. Was casing pulled? Yes  No  If yes, how much 3 feet  
Casing height above or below land surface \_\_\_\_\_ in.

**6** GROUT PLUG MATERIAL: 1 Naat cement 2 Cement grout **3** Bentonite 4 Other

Grout Plug Intervals From \_\_\_\_\_ ft. to \_\_\_\_\_ ft. From \_\_\_\_\_ ft. to \_\_\_\_\_ ft. From \_\_\_\_\_ ft. to \_\_\_\_\_ ft.

What is the nearest source of possible contamination:

1 Septic tank	6 Seepage pit	<b>11</b> Fuel storage	16 Other (specify below)
2 Sewer lines	7 Pit privy	12 Fertilizer storage	
3 Watertight sewer lines	8 Sewage lagoon	13 Insecticide storage	
4 Lateral lines	9 Feedyard	14 Abandoned water well	
5 Cess Pool	10 Livestock pens	15 Oil well/ Gas well	

Direction from well? \_\_\_\_\_ How many feet? \_\_\_\_\_

FROM	TO	CODE	PLUGGING MATERIALS
0	3		Native fill
3	36		Bentonite chips

**7** CONTRACTOR'S OR LANDOWNER'S CERTIFICATION: This water well was plugged under my jurisdiction and was completed on (mo/day/yr) 12/10/14 and this record is true to the best of my knowledge and belief. Kansas Water Well Contractor's License No. 12/15/14 under the business name of *Nick Holt* This Water Well Record was completed on (mo/day/yr) \_\_\_\_\_ Bluestem Environmental Engineering, Inc.

by (signature) \_\_\_\_\_

**INSTRUCTIONS:** Please fill in blanks and circle the correct answers. Send three copies to Kansas Department of Health and Environment, Bureau of Water, 1000 S W Jackson St., Ste. 420, Topeka, Kansas 66620-0001. Telephone: 785-296-3565. Send one to Water Well Owner and retain one for your records.