


1 LOCATION OF WATER WELL: County: Russell Fraction NW 1/4 NW 1/4 NE 1/4 Section Number 7 Township Number T 11 S Range Number R 12 EW

Distance and direction from nearest town or city street address of well if located within city? 19352 US Highway 281; Luray, Kansas

2 WATER WELL OWNER: R & J Service, Inc. RR#, St. Address, Box #: 5822 195th Street City, State, ZIP Code: Luray, Kansas 67649 Board of Agriculture, Division of Water Resources Application Number:

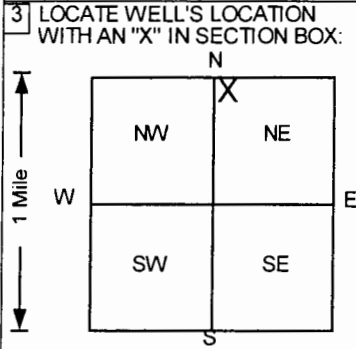

4 DEPTH OF COMPLETED WELL: 20 ft. ELEVATION: 1607.84. WELL'S STATIC WATER LEVEL: ft. below land surface measured on mo/day/yr. Pump test data: Well water was NA ft. after hours pumping. Est. Yield NA gpm. Bore Hole Diameter 8 in. to 20 ft. WELL WATER TO BE USED AS: 10 Monitoring well (checked).

5 TYPE OF BLANK CASING USED: 2 PVC (checked). Blank casing diameter 2 in. to 10 ft. Casing height above land surface 34.32 in. weight lbs./ft. Wall thickness or gauge No. SCH. 40. TYPE OF SCREEN OR PERFORATION MATERIAL: 7 PVC (checked). SCREEN OR PERFORATION OPENINGS ARE: 3 Mill slot (checked). SCREEN-PERFORATED INTERVALS: From 10 ft. to 20 ft. GRAVEL PACK INTERVALS: From 8.5 ft. to 20 ft.

6 GROUT MATERIAL: 2 Cement grout (checked), 3 Bentonite (checked). Grout Intervals: From 0 ft. to 2 ft., From 2 ft. to 8.5 ft. What is the nearest source of possible contamination: 16 Other (specify below) Underground Storage. Direction from well? N How many feet? 79

Table with columns: FROM, TO, LITHOLOGIC LOG, FROM, TO, PLUGGING INTERVALS. Rows show geological layers like Clay, Dark Brown; Clay, Yellow Brown with Tan Limestone Clas; Limestone, Buff; Clay, Orange Brown; Clay, Orange Brown; Clay, Brown. Includes MW-5, Tag # 00339210, Abovegrade and Project Name: R J Service.

7 CONTRACTOR'S OR LANDOWNER'S CERTIFICATION: This water well was (1) constructed, (2) reconstructed, or (3) plugged under my jurisdiction and was completed on (mo/day/year) 1/10/02 and this record is true to the best of my knowledge and belief. Kansas Water Well Contractor's License No. 527. This Water Well Record was completed on (mo/day/yr) 1/25/02 under the business name of GeoCore Services, Inc. by (signature) Bob Kelly

INSTRUCTIONS: Use typewriter or ball point pen. PLEASE PRESS FIRMLY and PRINT clearly. Please fill in blanks, underline or circle the correct answers. Send top three copies to Kansas Department of Health and Environment, Bureau of Water, Topeka, Kansas 66620-0001. Telephone: 913-296-5545. Send one to WATER WELL OWNER and retain one for your records.

OFFICE USE ONLY

T

R

EM

SEC

1/2

1/2

1/2