WATER WELL RECORD Form WWC-5

☐ Original Record ☐ Correction ☐ Change in Well Use

Division of Water Resources App. No. _____ Well ID MW7

1 LOCATION OF WATER WELL: County: Russell | Fraction: SW¼ SE¼ SW¼ SE¼ | Section Number: 7 | Township Number: T 11 S | Range Number: R 12 ☐ E ■ W

2 WELL OWNER: Last Name: Zvolanek First: Terry
Business: Midway Coop Association
Address: 210 Harrison
Address:
City: Osborne State: KS ZIP: 67473

Street or Rural Address where well is located (if unknown, distance and direction from nearest town or intersection): If at owner's address, check here: ☐
19363 KS-HWY 18
Luray, KS, 67649

3 LOCATE WELL WITH "X" IN SECTION BOX:

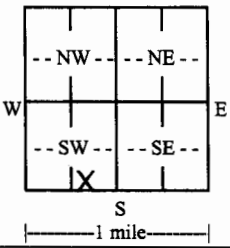

4 DEPTH OF COMPLETED WELL: 35 ft.
Depth(s) Groundwater Encountered: 1) >24 ft. 2) ..... ft. 3) ..... ft., or 4) ☐ Dry Well
WELL'S STATIC WATER LEVEL: 18.60 ft.
■ below land surface, measured on (mo-day-yr) 11-11-20
☐ above land surface, measured on (mo-day-yr) .....
Pump test data: Well water was ..... ft. after ..... hours pumping ..... gpm
Well water was ..... ft. after ..... hours pumping ..... gpm
Estimated Yield: ..... gpm
Bore Hole Diameter: 8.5 in. to 35 ft. and ..... in. to ..... ft.

5 Latitude: 39.11871 (decimal degrees)
Longitude: 99.69420 (decimal degrees)
Horizontal Datum: ☐ WGS 84 ■ NAD 83 ☐ NAD 27
Source for Latitude/Longitude:
☐ GPS (unit make/model: .....) (WAAS enabled? ☐ Yes ☐ No)
■ Land Survey ☐ Topographic Map
☐ Online Mapper: .....

6 Elevation: 1610.70 ft. ☐ Ground Level ■ TOC
Source: ■ Land Survey ☐ GPS ☐ Topographic Map ☐ Other .....

7 WELL WATER TO BE USED AS:
1. Domestic: ☐ Household ☐ Lawn & Garden ☐ Livestock
2. ☐ Irrigation
3. ☐ Feedlot
4. ☐ Industrial
5. ☐ Public Water Supply: well ID .....
6. ☐ Dewatering: how many wells? .....
7. ☐ Aquifer Recharge: well ID .....
8. ■ Monitoring: well ID MW7
9. Environmental Remediation: well ID ..... ☐ Air Sparge ☐ Soil Vapor Extraction ☐ Recovery ☐ Injection
10. ☐ Oil Field Water Supply: lease .....
11. Test Hole: well ID ..... ☐ Cased ☐ Uncased ☐ Geotechnical
12. Geothermal: how many bores? ..... a) Closed Loop ☐ Horizontal ☐ Vertical b) Open Loop ☐ Surface Discharge ☐ Inj. of Water
13. ☐ Other (specify): .....

Was a chemical/bacteriological sample submitted to KDHE? ☐ Yes ■ No If yes, date sample was submitted: .....
Water well disinfected? ☐ Yes ■ No

8 TYPE OF CASING USED: ☐ Steel ■ PVC ☐ Other ..... CASING JOINTS: ☐ Glued ☐ Clamped ☐ Welded ■ Threaded
Casing diameter 2 in. to 35 ft., Diameter ..... in. to ..... ft., Diameter ..... in. to ..... ft.
Casing height above land surface ..... in. Weight ..... lbs./ft. Wall thickness or gauge No. Sch 40

TYPE OF SCREEN OR PERFORATION MATERIAL:
☐ Steel ☐ Stainless Steel ☐ Fiberglass ■ PVC ☐ Other (Specify) .....
☐ Brass ☐ Galvanized Steel ☐ Concrete tile ☐ None used (open hole)

SCREEN OR PERFORATION OPENINGS ARE:
☐ Continuous Slot ■ Mill Slot ☐ Gauze Wrapped ☐ Torch Cut ☐ Drilled Holes ☐ Other (Specify) .....
☐ Louvered Shutter ☐ Key Punched ☐ Wire Wrapped ☐ Saw Cut ☐ None (Open Hole)

SCREEN-PERFORATED INTERVALS: From 20 ft. to 35 ft., From ..... ft. to ..... ft., From ..... ft. to ..... ft.
GRAVEL PACK INTERVALS: From 18 ft. to 35 ft., From ..... ft. to ..... ft., From ..... ft. to ..... ft.

9 GROUT MATERIAL: ☐ Neat cement ☐ Cement grout ■ Bentonite ■ Other Concrete Surface Completion 0 - 1
Grout Intervals: From 1 ft. to 18 ft., From ..... ft. to ..... ft., From ..... ft. to ..... ft.

Nearest source of possible contamination:
☐ Septic Tank ☐ Lateral Lines ☐ Pit Privy ☐ Livestock Pens ☐ Insecticide Storage
☐ Sewer Lines ☐ Cess Pool ☐ Sewage Lagoon ■ Fuel Storage ☐ Abandoned Water Well
☐ Watertight Sewer Lines ☐ Seepage Pit ☐ Feedyard ☐ Fertilizer Storage ☐ Oil Well/Gas Well
☐ Other (Specify) .....
Direction from well? East Distance from well? 75 ft.

10 FROM	TO	LITHOLOGIC LOG	FROM	TO	LITHO. LOG (cont.) or PLUGGING INTERVALS
0	0.5	Concrete			
0.5	8	Silty Clay (CL), brown			
8	18	Sandstone/Limestone lenses			
18	35	Shale, dark grey, weathered			

Notes: KDHE Storage Tanks (LUST) LSA Project
Midway Coop Luray Station, U6-84-15210, Luray

11 CONTRACTOR'S OR LANDOWNER'S CERTIFICATION: This water well was ■ constructed, ☐ reconstructed, or ☐ plugged under my jurisdiction and was completed on (mo-day-year) 11-09-20 and this record is true to the best of my knowledge and belief. Kansas Water Well Contractor's License No. 585 This Water Well Record was completed on (mo-day-year) 12-08-20 under the business name of Associated Environmental, Inc. Signature .....

Mail 1 white copy along with a fee of $5.00 for each constructed well to: Kansas Department of Health and Environment, Bureau of Water, GWTS Section, 1000 SW Jackson St., Suite 420, Topeka, Kansas 66612-1367. Mail one to Water Well Owner and retain one for your records. Telephone 785-296-5524.

Visit us at http://www.kdheks.gov/waterwell/index.html KSA 82a-1212 **Revised 7/10/2015**

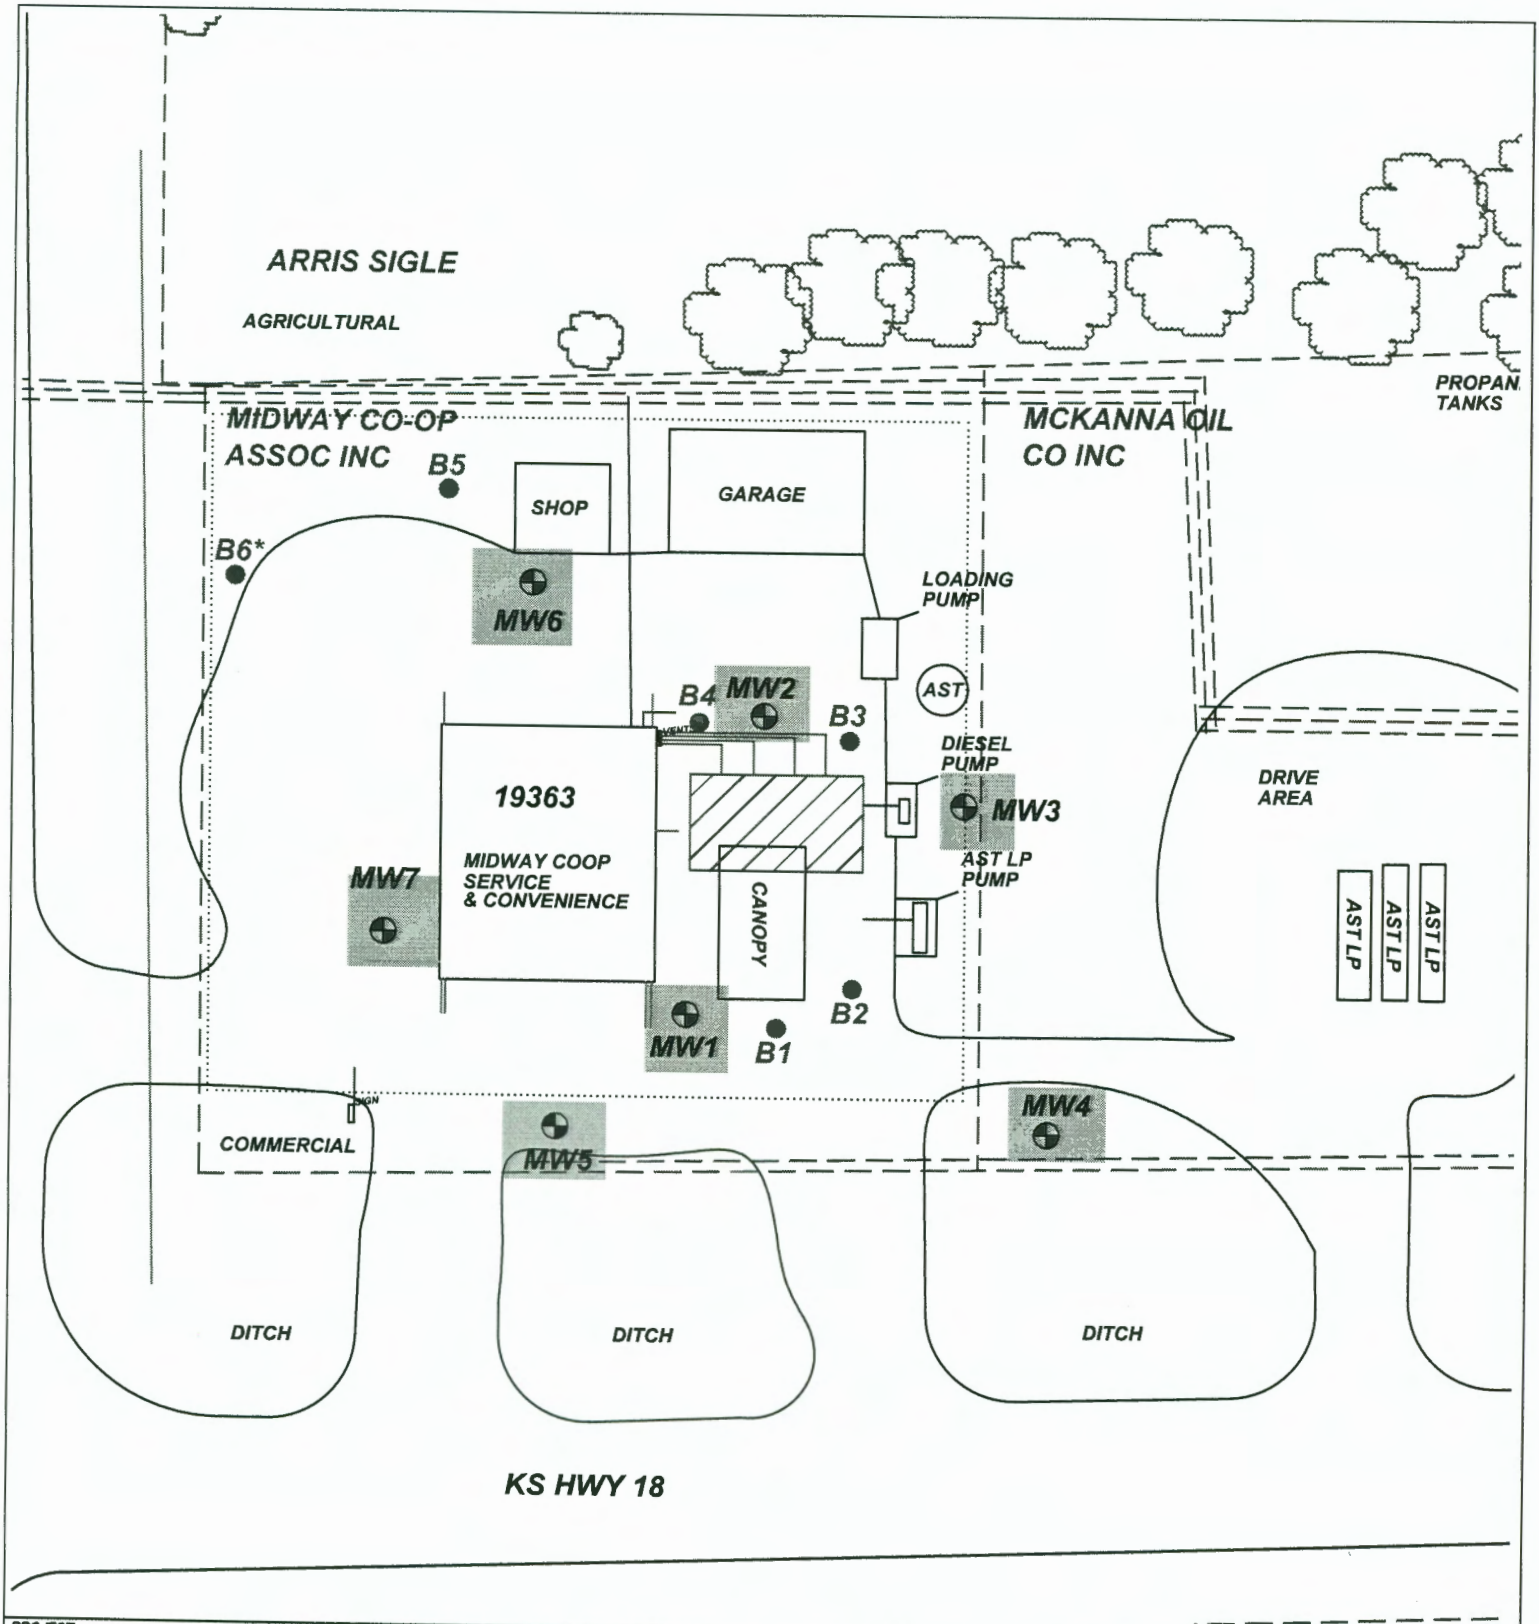

PROJECT:	MIDWAY CO-OP LURAY STATION
ADDRESS:	19363 HWY 18
LOCATION:	LURAY, KS
DRAWN BY:	C. ROE
DATE:	4/20/20
REVISED BY:	C. ROE
DATE:	11/25/20
AEI JOB #:	TF529
KDHE JOB #:	U6-084-15210
SCALE:	1" = 50'

0 25 50

TITLE: **FIGURE 2.3 AREA BASE MAP CLOSE-UP**

ASSOCIATED ENVIRONMENTAL INC.

NOTES: *= indicates boring for saturated and unsaturated zone hydrologic data.

LEGEND:

= FORMER UST BASIN

= MONITORING WELL

= SOIL BORING

= SUBJECT PROPERTY

= PARCEL BOUNDARY

= OVERHEAD ELECTRIC (10-25')

= BURIED ELECTRIC (2-5')

= BURIED WATER (3-6')

= BURIED GAS (2-4')

= BURIED SEWER (2-12')

= BURIED CABLE (2-5')