


1 LOCATION OF WATER WELL: County: Russell Fraction NE 1/4 NW 1/4 NW 1/4 Section Number 8 Township Number T 11 S Range Number R 12

Distance and direction from nearest town or city street address of well if located within city? In Luray, Kansas

2 WATER WELL OWNER: Jack Schneider RR#, St. Address, Box #: RRT City, State, ZIP Code: Luray, Kansas 67649 Board of Agriculture, Division of Water Resources Application Number:

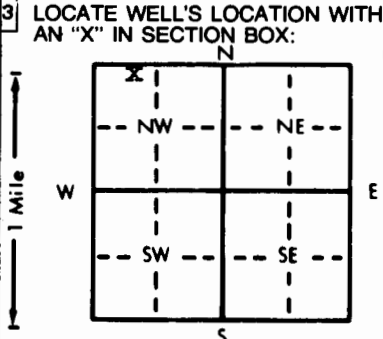

3 LOCATE WELL'S LOCATION WITH AN 'X' IN SECTION BOX: 4 DEPTH OF COMPLETED WELL: 40 ft. ELEVATION: Valley. WELL'S STATIC WATER LEVEL: 20 ft. below land surface measured on 5/9/89. Pump test data: Well water was 20 ft. after 1 hour pumping 15 gpm. Est. Yield: 15 gpm. Bore Hole Diameter: 10 in. to 40 ft. WELL WATER TO BE USED AS: 1 Domestic, 5 Public water supply, 8 Air conditioning, 11 Injection well, 2 Irrigation, 4 Industrial, 7 Lawn and garden only, 10 Observation well. Was a chemical/bacteriological sample submitted? No. Water Well Disinfected? Yes.

5 TYPE OF BLANK CASING USED: 2 Steel, 3 RMP (SR), 4 ABS, 5 Wrought iron, 6 Asbestos-Cement, 7 Fiberglass, 8 Concrete tile, 9 Other (specify below), 10 Asbestos-cement. Blank casing diameter: 5 in. to 20 ft., Dia. Casing height above land surface: 24 in., weight 160 lbs./ft. Wall thickness or gauge No. 26. TYPE OF SCREEN OR PERFORATION MATERIAL: 7 PVC, 8 RMP (SR), 10 Asbestos-cement. SCREEN OR PERFORATION OPENINGS ARE: 8 Saw cut, 9 Drilled holes, 10 Other (specify). SCREEN-PERFORATED INTERVALS: From 20 ft. to 40 ft. GRAVEL PACK INTERVALS: From 20 ft. to 40 ft.

6 GROUT MATERIAL: 1 Neat cement, 2 Cement grout, 3 Bentonite, 4 Other. Grout Intervals: From 0 ft. to 20 ft. What is the nearest source of possible contamination: None. 1 Septic tank, 4 Lateral lines, 7 Pit privy, 10 Livestock pens, 14 Abandoned water well, 2 Sewer lines, 5 Cess pool, 8 Sewage lagoon, 11 Fuel storage, 15 Oil well/Gas well, 3 Watertight sewer lines, 6 Seepage pit, 9 Feedyard, 12 Fertilizer storage, 16 Other (specify below), 13 Insecticide storage.

Direction from well? How many feet? Table with columns FROM, TO, LITHOLOGIC LOG. Data: 0-4 Topsoil, 4-18 River mud, 18-24 Gravel, 24-30 Clay, 30-40 Gray shale.

7 CONTRACTOR'S OR LANDOWNER'S CERTIFICATION: This water well was (1) constructed, (2) reconstructed, or (3) plugged under my jurisdiction and was completed on (mo/day/year) 5/9/89 and this record is true to the best of my knowledge and belief. Kansas Water Well Contractor's License No. 199. This Water Well Record was completed on (mo/day/yr) 5/22/89 under the business name of Karst Water Well Drilling & Service Inc. by (signature).

INSTRUCTIONS: Use typewriter or ball point pen. PLEASE PRESS FIRMLY and PRINT clearly. Please fill in blanks, underline or circle the correct answers. Send top three copies to Kansas Department of Health and Environment, Office of Oil Field and Environmental Geology, Regulation and Permitting Section, Topeka, Kansas 66620-7500, Telephone: 913-862-9360. Send one to WATER WELL OWNER and retain one for your records.