


1 LOCATION OF WATER WELL: County: Russell Fraction: Se 1/4 Se 1/4 Sw 1/4 Section Number: 18 Township Number: T 11 S Range Number: R 12

Distance and direction from nearest town or city street address of well if located within city? Luray 1s

2 WATER WELL OWNER: Chris Meyer RR#: Sylvan Grove, Ks. 67481 Board of Agriculture, Division of Water Resources Application Number:

3 LOCATE WELL'S LOCATION WITH AN "X" IN SECTION BOX:

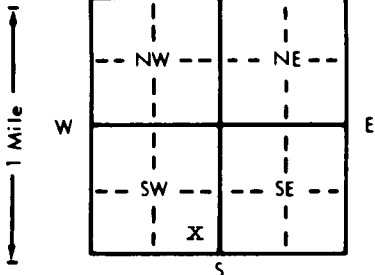

4 DEPTH OF COMPLETED WELL: 185 ft. ELEVATION: unknown

Depth(s) Groundwater Encountered 1. 145 ft. 2. ft. 3. ft. WELL'S STATIC WATER LEVEL 145 ft. below land surface measured on mo/day/yr 4/28/89 Pump test data: Well water was 18 ft. after hours pumping gpm Est. Yield 18 gpm: Well water was ft. after hours pumping gpm Bore Hole Diameter 8 in. to 185 ft., and in. to ft. WELL WATER TO BE USED AS: 5 Public water supply 8 Air conditioning 11 Injection well 2 Irrigation 4 Industrial 7 Lawn and garden only 10 Monitoring well

5 TYPE OF BLANK CASING USED: 1 Steel 3 RMP (SR) 5 Wrought iron 8 Concrete tile CASING JOINTS: Glued X Clamped 2 PVC 4 ABS 6 Asbestos-Cement 9 Other (specify below) Welded 7 Fiberglass Threaded

Blank casing diameter 5 in. to 145 ft., Dia in. to ft., Dia in. to ft. Casing height above land surface 12 in., weight 2.8 lbs./ft. Wall thickness or gauge No. Sch. 40

TYPE OF SCREEN OR PERFORATION MATERIAL: 1 Steel 3 Stainless steel 5 Fiberglass 8 RMP (SR) 10 Asbestos-cement 2 Brass 4 Galvanized steel 6 Concrete tile 9 ABS 11 Other (specify) 12 None used (open hole)

SCREEN OR PERFORATION OPENINGS ARE: 1 Continuous slot 3 Mill slot 5 Gauzed wrapped 8 Saw cut 11 None (open hole) 2 Louvered shutter 4 Key punched 6 Wire wrapped 9 Drilled holes 7 Torch cut 10 Other (specify)

SCREEN-PERFORATED INTERVALS: From 145 ft. to 185 ft., From ft. to ft. GRAVEL PACK INTERVALS: From 20 ft. to 185 ft., From ft. to ft.

6 GROUT MATERIAL: 1 Neat cement 20 2 Cement grout 3 Bentonite 4 Other Grout Intervals: From ft. to ft., From ft. to ft., From ft. to ft.

What is the nearest source of possible contamination: 1 Septic tank 4 Lateral lines 7 Pit privy 10 Livestock pens 14 Abandoned water well 2 Sewer lines 5 Cess pool 8 Sewage lagoon 11 Fuel storage 15 Oil well/Gas well 3 Watertight sewer lines 6 Seepage pit 9 Feedyard 12 Fertilizer storage 16 Other (specify below) Direction from well? southwest How many feet? 450

Table with columns: FROM, TO, LITHOLOGIC LOG, FROM, TO, PLUGGING INTERVALS. Row 1: 0, 100, top soil & clay, , , Row 2: 100, 185, sand rock, , ,

7 CONTRACTOR'S OR LANDOWNER'S CERTIFICATION: This water well was (1) constructed, (2) reconstructed, or (3) plugged under my jurisdiction and was completed on (mo/day/year) 4/28/89 and this record is true to the best of my knowledge and belief. Kansas Water Well Contractor's License No. 186 This Water Well Record was completed on (mo/day/yr) 5/21/89 under the business name of Kelly's Water Well by (signature) [Signature]

INSTRUCTIONS: Use typewriter or ball point pen. PLEASE PRESS FIRMLY and PRINT clearly. Please fill in blanks, underline or circle the correct answers. Send top three copies to Kansas Department of Health and Environment, Bureau of Water Protection, Topeka, Kansas 66620-7320. Telephone: 913-296-5514. Send one to WATER WELL OWNER and retain one for your records.