


1 LOCATION OF WATER WELL: County: Russell Fraction: SW 1/4 NW 1/4 NE 1/4 Section Number: 7 Township Number: T 11 S Range Number: R 14 E/W

Distance and direction from nearest town or city street address of well if located within city? Main Street and D Avenue, Paradise, Kansas

2 WATER WELL OWNER: KDHE

RR#, St. Address, Box #: Forbes Field, Bldg. 740 Board of Agriculture, Division of Water Resources City, State, ZIP Code: Topeka, Kansas 66620 Application Number:

3 LOCATE WELL'S LOCATION WITH AN "X" IN SECTION BOX:

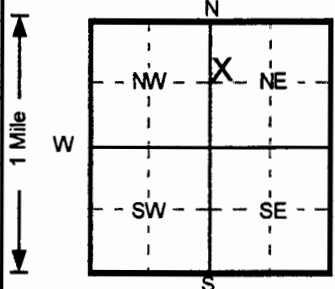

4 DEPTH OF COMPLETED WELL: 35 ft. ELEVATION: 1707.38. Depth(s) Groundwater Encountered 1. ft. 2. ft. 3. ft. WELL'S STATIC WATER LEVEL: 28.23 ft. below land surface measured on mo/day/yr 10/23/98. Pump test data: Well water was NA ft. after NA hours pumping. Est. Yield: NA gpm. Well water was NA ft. after NA hours pumping. Bore Hole Diameter: 8 in. to 35 ft., and in. to in. to ft. WELL WATER TO BE USED AS: 5 Public water supply, 8 Air conditioning, 11 Injection well, 1 Domestic, 3 Feedlot, 6 Oil field water supply, 9 Dewatering, 12 Other (Specify below), 2 Irrigation, 4 Industrial, 7 Lawn and garden only, 10 Monitoring well. Was a chemical/bacteriological sample submitted to Department? Yes.....No.....; If yes, mo/day/yr sample was submitted. Water Well Disinfected? Yes No

5 TYPE OF BLANK CASING USED: 1 Steel, 2 PVC, 3 RMP (SR), 4 ABS, 5 Wrought iron, 6 Asbestos-Cement, 7 Fiberglass, 8 Concrete tile, 9 Other (specify below). CASING JOINTS: Glued, Clamped, Welded, Threaded. Blank casing diameter 2 in. to 20 ft., Dia. 20 in. to ft., Dia. in. to ft. Casing height above land surface -4.44 in., weight Sch 40, lbs./ft. Wall thickness or gauge No. TYPE OF SCREEN OR PERFORATION MATERIAL: 1 Steel, 2 Brass, 3 Stainless steel, 4 Galvanized steel, 5 Fiberglass, 6 Concrete tile, 7 PVC, 8 RMP (SR), 9 ABS, 10 Asbestos-cement, 11 Other (specify), 12 None used (open hole). SCREEN OR PERFORATION OPENINGS ARE: 1 Continuous slot, 2 Louvered shutter, 3 Mill slot, 4 Key punched, 5 Gauzed wrapped, 6 Wire wrapped, 7 Torch cut, 8 Saw cut, 9 Drilled holes, 10 Other (specify), 11 None (open hole). SCREEN-PERFORATED INTERVALS: From 20 ft. to 35 ft., From ft. to ft., From ft. to ft., From ft. to ft. GRAVEL PACK INTERVALS: From 18 ft. to 35 ft., From ft. to ft., From ft. to ft., From ft. to ft.

6 GROUT MATERIAL: 1 Neat cement, 2 Cement grout, 3 Bentonite, 4 Other. Grout Intervals: From 0 ft. to 16 ft., From 16 ft. to 18 ft., From ft. to ft., From ft. to ft. What is the nearest source of possible contamination: 1 Septic tank, 2 Sewer lines, 3 Watertight sewer lines, 4 Lateral lines, 5 Cess pool, 6 Seepage pit, 7 Pit privy, 8 Sewage lagoon, 9 Feedyard, 10 Livestock pens, 11 Fuel storage, 12 Fertilizer storage, 13 Insecticide storage, 14 Abandoned water well, 15 Oil well/Gas well, 16 Other (specify below) Tank Basin. Direction from well? South How many feet? 70

Table with columns: FROM, TO, LITHOLOGIC LOG, FROM, TO, PLUGGING INTERVALS. Data rows include: 0 to 0.5 Asphalt; 0.5 to 9 Clay, Light Brown; 9 to 35 Clay, Light Brown. Additional text: MW5, Tag # 00283904, Flushmount; Project Name: Former Natoma Coop Service Station; GeoCore # 681, KDHE # U6 084 TBD

7 CONTRACTOR'S OR LANDOWNER'S CERTIFICATION: This water well was (1) constructed, (2) reconstructed, or (3) plugged under my jurisdiction and was completed on (mo/day/year) 9/23/98 and this record is true to the best of my knowledge and belief. Kansas Water Well Contractor's License No. 527. This Water Well Record was completed on (mo/day/yr) 10/22/98 under the business name of GeoCore Services, Inc. by (signature) Dale Robb