


1 LOCATION OF WATER WELL: Fraction SW 1/4 1/4 1/4 Section Number 35 Township Number T 11 S Range Number R 14 E/W  
 County: RUSSELL

Distance and direction from nearest town or city street address of well if located within city?  
10 miles north of Russell

2 WATER WELL OWNER: EVELYN STIELOW  
 RR#, St. Address, Box #: \_\_\_\_\_ Board of Agriculture, Division of Water Resources  
 City, State, ZIP Code: RUSSELL, KANSAS 67665 Application Number: \_\_\_\_\_

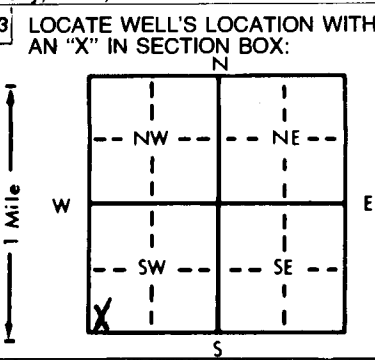

4 DEPTH OF COMPLETED WELL: 43 ft. ELEVATION: \_\_\_\_\_  
 Depth(s) Groundwater Encountered 1. 23 ft. 2. 24 ft. 3. \_\_\_\_\_ ft.  
 WELL'S STATIC WATER LEVEL 23 ft. below land surface measured on mo/day/yr May 16, 84  
 Pump test data: Well water was 23 ft. after 2 hours pumping 10 gpm  
 Est. Yield 12 gpm: Well water was \_\_\_\_\_ ft. after \_\_\_\_\_ hours pumping \_\_\_\_\_ gpm  
 Bore Hole Diameter: 8 in. to 43 ft., and \_\_\_\_\_ in. to \_\_\_\_\_ ft.  
 WELL WATER TO BE USED AS:  
 5 Public water supply 8 Air conditioning 11 Injection well  
 1 Domestic 3 Feedlot 6 Oil field water supply 9 Dewatering 12 Other (Specify below)  
 2 Irrigation 4 Industrial 7 Lawn and garden only 10 Observation well  
 Was a chemical/bacteriological sample submitted to Department? Yes X No \_\_\_\_\_; If yes, mo/day/yr sample was sub-  
 mitted May 14, 1984 Water Well Disinfected? Yes No \_\_\_\_\_

5 TYPE OF BLANK CASING USED:  
 1 Steel 3 RMP (SR) 5 Wrought iron 8 Concrete tile CASING JOINTS: Glued XX Clamped \_\_\_\_\_  
 2 PVC 4 ABS 6 Asbestos-Cement 9 Other (specify below) Welded \_\_\_\_\_  
 7 Fiberglass Threaded \_\_\_\_\_  
 Blank casing diameter 5 in. to 23 ft., Dia. \_\_\_\_\_ in. to \_\_\_\_\_ ft., Dia. \_\_\_\_\_ in. to \_\_\_\_\_ ft.  
 Casing height above land surface 24 in., weight 2.82 lbs./ft. Wall thickness or gauge No. .265  
 TYPE OF SCREEN OR PERFORATION MATERIAL:  
 1 Steel 3 Stainless steel 5 Fiberglass 7 PVC 10 Asbestos-cement  
 2 Brass 4 Galvanized steel 6 Concrete tile 8 RMP (SR) 11 Other (specify) \_\_\_\_\_  
 9 ABS 12 None used (open hole)  
 SCREEN OR PERFORATION OPENINGS ARE:  
 1 Continuous slot 3 Mill slot 5 Gauzed wrapped 8 Saw cut 11 None (open hole)  
 2 Louvered shutter 4 Key punched 6 Wire wrapped 9 Drilled holes  
 7 Torch cut 10 Other (specify) \_\_\_\_\_  
 SCREEN-PERFORATED INTERVALS: From 23 ft. to 43 ft., From \_\_\_\_\_ ft. to \_\_\_\_\_ ft.  
 From \_\_\_\_\_ ft. to \_\_\_\_\_ ft., From \_\_\_\_\_ ft. to \_\_\_\_\_ ft.  
 GRAVEL PACK INTERVALS: From 21 ft. to 43 ft., From \_\_\_\_\_ ft. to \_\_\_\_\_ ft.  
 From \_\_\_\_\_ ft. to \_\_\_\_\_ ft., From \_\_\_\_\_ ft. to \_\_\_\_\_ ft.

6 GROUT MATERIAL: 1 Neat cement 2 Cement grout 3 Bentonite 4 Other \_\_\_\_\_  
 Grout Intervals: From 5 ft. to 15 ft., From \_\_\_\_\_ ft. to \_\_\_\_\_ ft., From \_\_\_\_\_ ft. to \_\_\_\_\_ ft.  
 What is the nearest source of possible contamination:  
 1 Septic tank 4 Lateral lines 7 Pit privy 10 Livestock pens 14 Abandoned water well  
 2 Sewer lines 5 Cess pool 8 Sewage lagoon 11 Fuel storage 15 Oil well/Gas well  
 3 Watertight sewer lines 6 Seepage pit 9 Feedyard 12 Fertilizer storage 16 Other (specify below)  
 13 Insecticide storage \_\_\_\_\_  
 Direction from well? East How many feet? 150

FROM	TO	LITHOLOGIC LOG	FROM	TO	LITHOLOGIC LOG
<u>0</u>	<u>6</u>	<u>Top soil</u>			
<u>6</u>	<u>24</u>	<u>Clay</u>			
<u>24</u>	<u>41</u>	<u>Gravel</u>			
<u>41</u>	<u>43</u>	<u>Shale</u>			

7 CONTRACTOR'S OR LANDOWNER'S CERTIFICATION: This water well was (1) constructed, (2) reconstructed, or (3) plugged under my jurisdiction and was completed on (mo/day/year) May 16, 1984 and this record is true to the best of my knowledge and belief. Kansas Water Well Contractor's License No. 360 This Water Well Record was completed on (mo/day/yr) Aug. 5, 1984 under the business name of WAGNERS WATER WELL DRILLING by (signature) William L. Wagner

INSTRUCTIONS: Use typewriter or ball point pen, **PLEASE PRESS FIRMLY** and **PRINT** clearly. Please fill in blanks, underline or circle the correct answers. Send top three copies to Kansas Department of Health and Environment, Division of Environment, Environmental Geology Section, Topeka, KS 66620. Send one to WATER WELL OWNER and retain one for your records.

PRE-PAID →

OFFICE USE ONLY

T

R

EW

SEC.

1/4

1/4

1/4