

WATER WELL RECORD

Form WWC-5

Division of Water Resources App. No.

1 LOCATION OF WATER WELL: County: Shawnee	Fraction ¼ ¼ SE ¼ SE ¼	Section Number 26	Township No. T 11 S	Range Number R 15 <input checked="" type="checkbox"/> E <input type="checkbox"/> W
Street/Rural Address of Well Location; if unknown, distance & direction from nearest town or intersection: If at owner's address, check here <input type="checkbox"/> North of SW 6th & MacVicar		Global Positioning System (GPS) information: Latitude: <u>39.059693</u> (in decimal degrees) Longitude: <u>-95.707900</u> (in decimal degrees) Elevation: Datum: <input type="checkbox"/> WGS 84, <input type="checkbox"/> NAD 83, <input checked="" type="checkbox"/> NAD 27 Collection Method: <input type="checkbox"/> GPS unit (Make/Model:) <input checked="" type="checkbox"/> Digital Map/Photo, <input type="checkbox"/> Topographic Map, <input type="checkbox"/> Land Survey Est. Accuracy: <input type="checkbox"/> <3 m, <input type="checkbox"/> 3-5 m, <input type="checkbox"/> 5-15 m, <input type="checkbox"/> >15 m		
2 WATER WELL OWNER: Terracon Consultants, Inc. RR#, Street Address, Box #: 3113 SW VanBuren City, State, ZIP Code : Topeka, Kansas 66611				

<p>3 LOCATE WELL WITH AN "X" IN SECTION BOX:</p> <p style="text-align: center;">N</p> <table style="margin: auto; border-collapse: collapse;"> <tr> <td style="border: 1px solid black; padding: 5px;">NW</td> <td style="border: 1px solid black; padding: 5px;">NE</td> </tr> <tr> <td style="border: 1px solid black; padding: 5px;">SW</td> <td style="border: 1px solid black; padding: 5px;">SE</td> </tr> </table> <p style="text-align: center;">S</p> <p style="text-align: center;">----- 1 mile -----</p>	NW	NE	SW	SE	<p>4 DEPTH OF COMPLETED WELL 15 ft.</p> <p>Depth(s) Groundwater Encountered (1) <u>6.15</u> ft. (2) ft. (3) ft.</p> <p>WELL'S STATIC WATER LEVEL <u>6.15</u> ft. below land surface measured on mo/day/yr. <u>2/18/14</u></p> <p>Pump test data: Well water was ft. after hours pumping gpm</p> <p>EST. YIELD gpm. Well water was ft. after hours pumping gpm</p> <p>Bore Hole Diameter <u>6</u> in. to ft., and in. to ft.</p> <p>WELL WATER TO BE USED AS: <input type="checkbox"/> Public water supply <input type="checkbox"/> Geothermal <input type="checkbox"/> Injection well <input type="checkbox"/> Domestic <input type="checkbox"/> Feedlot <input type="checkbox"/> Oil field water supply <input type="checkbox"/> Dewatering <input type="checkbox"/> Other (Specify below) <input type="checkbox"/> Irrigation <input type="checkbox"/> Industrial <input type="checkbox"/> Domestic-lawn & garden <input checked="" type="checkbox"/> Monitoring well B-13</p> <p>Was a chemical/bacteriological sample submitted to Department? <input type="checkbox"/> Yes <input type="checkbox"/> No If yes, mo/day/yr sample was submitted.....</p> <p>Water well disinfected? <input type="checkbox"/> Yes <input checked="" type="checkbox"/> No</p>
NW	NE				
SW	SE				

5 TYPE OF CASING USED: Steel PVC Other

CASING JOINTS: Glued Clamped Welded Threaded

Casing diameter 2 in. to ft., Diameter in. to ft., Diameter in. to ft.

Casing height above land surface in., Weight lbs./ft., Wall thickness or gauge No.

TYPE OF SCREEN OR PERFORATION MATERIAL:
 Steel Stainless Steel PVC Other (Specify)
 Brass Galvanized Steel None used (open hole)

SCREEN OR PERFORATION OPENINGS ARE:
 Continuous slot Mill slot Gauze wrapped Torch cut Drilled holes None (open hole)
 Louvered shutter Key punched Wire wrapped Saw cut Other (specify)

SCREEN-PERFORATED INTERVALS: From 10 ft. to 15 ft., From ft. to ft.
 From ft. to ft., From ft. to ft.

GRAVEL PACK INTERVALS: From ft. to ft., From ft. to ft.
 From ft. to ft., From ft. to ft.

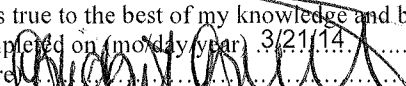
6 GROUT MATERIAL: Neat cement Cement grout Bentonite Other

Grout Intervals: From 0 ft. to ft., From ft. to ft., From ft. to ft.

What is the nearest source of possible contamination:
 Septic tank Lateral lines Pit privy Livestock pens Insecticide storage Other (specify below)
 Sewer lines Cesspool Sewage lagoon Fuel storage Abandoned water well
 Watertight sewer lines Seepage pit Feedyard Fertilizer storage Oil well/gas well

Direction from well SE Distance from well 500 feet

FROM	TO	LITHOLOGIC LOG	FROM	TO	LITHO. LOG (cont.) or PLUGGING INTERVALS
0	4	Fill-silty clay, dark brown, moist			
4	8.5	Silty lean clay, light to orange br			
8.5	9.0	Silty lean clay, with sand and gr			
9.0	13.5	Shale, or brown, moist, hard			
13.5	15	Shale, orange brown			

7 CONTRACTOR'S OR LANDOWNER'S CERTIFICATION: This water well was constructed, reconstructed, or plugged under my jurisdiction and was completed on (mo/day/year) 2/18/14 and this record is true to the best of my knowledge and belief. Kansas Water Well Contractor's License No. 416 This Water Well Record was completed on (mo/day/year) 3/21/14 under the business name of Terracon Consultants, Inc. by (signature) 

INSTRUCTIONS: Use typewriter or ball point pen. PLEASE PRESS FIRMLY and PRINT clearly. Please fill in blanks and check the correct answers. Send one copy to Kansas Department of Health and Environment, Bureau of Water, Geology Section, 1000 SW Jackson St., Suite 420, Topeka, Kansas 66612-1367. Telephone 785-296-5524. Send one copy to WATER WELL OWNER and retain one for your records. Include fee of \$5.00 for each constructed well. Visit us at <http://www.kdheks.gov/waterwell/index.html>